

RECONNAISSANCE & MAINTENANCE REPORT

STATION PENRITH BIRTH RES (P)

This Trig. Station has been:-

Note: Cross out word or words which do not apply

- 1. Completely cleared to permit 360° vision to surrounding Trigs. 1/0
- 2. Cleared by lanes bearing..... from Trig. Mast
- 3. Trig. Mast & Vanes have been painted white & black respectively.
- 4. The Trig. was unpiled/not unpiled, dimensions now being: ~~Station~~ **NEW STATION**  
Description of mark **STEEL PILLAR** should be explicit, e.g. Steel plug, Brass plug, Bolt, G.I. Pipe

Description of mark **STEEL PILLAR** ~~Station~~ **NEW STATION** should be explicit, e.g. Steel plug, Brass plug, Bolt, G.I. Pipe  
Height of mark ~~1.39~~ **2.17** m above ~~rock/concrete~~ **rock/concrete** m below G.L.  
Height of Top Vanes to Top Mark **7.35** m. Diameter of Vanes (vertical) **0.6** m.

~~Height of Cairn~~.....m. Diameter of Cairn.....m.

- Length of Mast .....m. (approximate if not unpiled)
- 5. A.....set in conc./rock has been placed.....m. bearing.....°M from Trig. Mast
- 6. A.....set in conc./soil has been placed.....m. bearing.....°M from Trig. Mast
- 7. A.....set in conc./soil has been placed.....m. bearing.....°M from Trig. Mast
- 8. A.....set in conc./rock has been placed.....m. bearing.....°M from Trig. Mast

- 9. Connection.....to.....m. bearing.....°M
- 10. Connection.....to.....m. bearing.....°M
- 11. Connection.....to.....m. bearing.....°M
- 12. Connection.....to.....m. bearing.....°M

13. Diff. Ht. **TOP OF PILLAR** is **16.933** m. ~~above~~ **below** **P.M. 12.601.8M 2**

- 14. Diff. Ht. .... is ..... m. ~~above~~ **below** .....
- 15. Diff. Ht. .... is ..... m. ~~above~~ **below** .....
- 16. Diff. Ht. .... is ..... m. ~~above~~ **below** .....

Prepared by: ..... Checked: .....

Noted on U.T.M. Card


Map Sheet: No: .....

Inspected by: **R. Hobb** Date: **9-7-85**

Authority **M.W.S. & D.B.** Field Book: **24 6620**

Beacon Diagram

Not to Scale

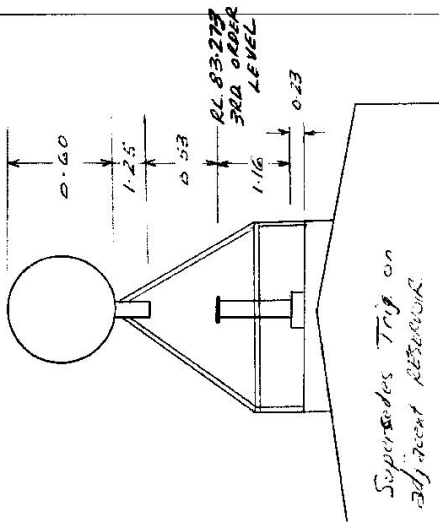

Date: ..... Record of Station


Checked

