


Department of Lands  
 Integral Survey of N.S.W.  
**RECONNAISSANCE and MAINTENANCE REPORT**  
 Note: Cross out word or words which do not apply

STATION **TS 10878 SACRED HEART R.W.K.**  
 Co: **CUMBERLAND** Ph: **ALEXANDRIA**  
 Map Sheet: **SYDNEY** No: **U 1845/8**  
 Inspected by: \_\_\_\_\_ Date: \_\_\_\_\_  
 Authority: \_\_\_\_\_ Field Book: \_\_\_\_\_  
 Beacon Diagram: \_\_\_\_\_ Not to Scale

This Trig. Station has been:-  
 1. Completely cleared to permit 360° vision to surrounding Trigs.  
 2. Cleared by lances bearing ..... from Trig. Mast  
 3. Trig. Mast & Vanes have been painted white & black respectively.  
 4. The Trig. was unpiled/not unpiled, dimensions now being:  
 Description of mark **CHURCH SPIRE** should be explicit, e.g. Steel plug, Brass plug, Ball, Concrete Pillar  
 Height of mark..... m <sup>above</sup> rock, concrete <sup>below</sup> G.L.  
 Height of Top Vanes to Top Mark/Top pillar plate ..... m Diameter of Vanes (vertical) ..... m.  
 Height of Cairn..... m. Diameter of Cairn..... m.  
 Length of Mast..... m. (approximate if not unpiled)  
 5. A ..... set in conc. rock has been placed at ..... m from Trig. Mast  
 6. A ..... set in conc. soil has been placed at ..... m from Trig. Mast  
 7. A ..... set in conc. soil has been placed at ..... m from Trig. Mast  
 8. A ..... set in conc. rock has been placed at ..... m from Trig. Mast  
 9. Connection..... to..... m. bearing.....°M  
 10. Connection..... to..... m. bearing.....°M  
 11. Connection..... to..... m. bearing.....°M  
 12. Connection..... to..... m. bearing.....°M  
 13. Diff. Ht. .... is..... m. <sup>above</sup> <sup>below</sup>  
 14. Diff. Ht. .... is..... m. <sup>above</sup> <sup>below</sup>  
 15. Diff. Ht. .... is..... m. <sup>above</sup> <sup>below</sup>  
 16. Diff. Ht. .... is..... m. <sup>above</sup> <sup>below</sup>

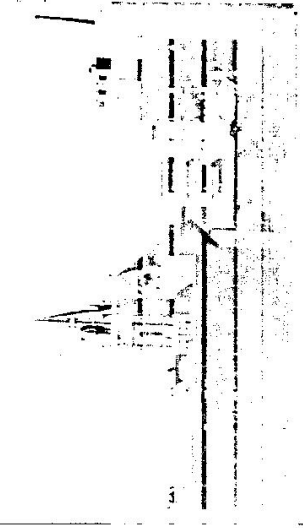

Date	Record of Station

Prepared by: APAC Checked: \_\_\_\_\_

TS  
STATION 10878 SACRED HEART

Owners Name: CATHOLIC CHURCH

Current Occupant:

Address:

Address:


Access

ROMAN CATHOLIC CHURCH "OUR LADY OF THE SACRED HEART"  
AT ANOCA ST, RANDWICK

Not to Scale

Station Diagram

North

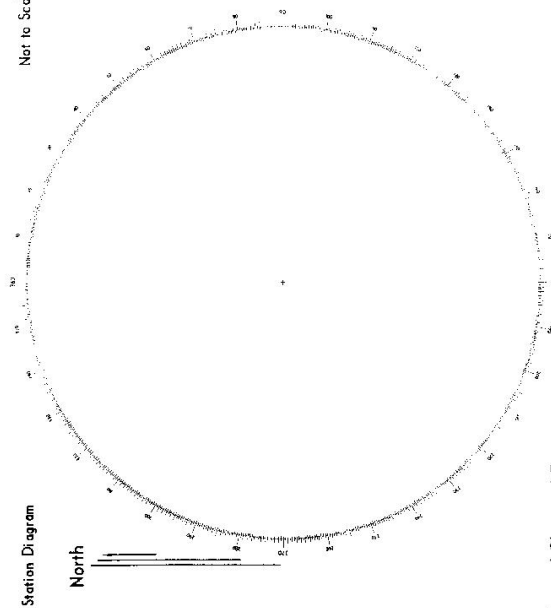

List of Observed Directions:-

Standpoint:

Station	Direction	Station	Direction

Standpoint:

Station	Direction	Station	Direction