

TS 10879

Department of Lands
 RECONNAISSANCE and MAINTENANCE REPORT

STATION TS CHAIN OF PONDS


Co: MULGOA
 Ph: CUMBERLAND
 Map Sheet: MULGOA
 No: U6452/3
 Inspected by: H. C. BORDEE
 Date: 11-6-86
 Authority: C.M.A.
 Field Book: Valuation Book
 No: PDP 3550
 Not to Scale
 Beacon Diagram

This Trig. Station has been:-
 Note: Cross out word or words which do not apply

1. Completely cleared to permit 360° vision to surrounding Trigs.
2. Cleared by lanes bearing from Trig-Mast Pillar
3. Trig. Mast & Vanes have been painted white & black respectively.
4. The Trig. was unspiled/rot-unspiled, dimensions now being: should be explicit, e.g. Steel plug, Brass plug, Bolt, Concrete Pillar

Description of mark: S/Steel Pillar Plate
 Height of mark: 1.400 m above ~~rock~~ concrete G.L.
 Height of Top Vanes to Top Mark/Top pillar plate: m Diameter of Vanes (vertical): m.
 Height of Cairn: m. Diameter of Cairn: m.

- Length of Mast: m. (approximate if not unspiled)
 S/Steel Pin
 5. A PM 57931 set in conc/rock has been placed at 8.778 m. bearing 90 °M from Trig. Mast pillar
 6. A Copper Nail set in conc/soil has been placed at 4.989 m. bearing 213 °M from Trig. Mast pillar
 7. A set in conc/soil has been placed at m. bearing °M from Trig. Mast/pillar
 8. A set in conc/rock has been placed at m. bearing °M from Trig. Mast/pillar
 S/Steel Pin
 9. Connection PM 57931 to Copper Spike 11.760 m. bearing 252 °M
 10. Connection: to m. bearing °M
 11. Connection: to m. bearing °M
 12. Connection: to m. bearing °M
 13. Diff. Ht. Pillar Plate is 2.259 m. above PM 57931
 14. Diff. Ht. Pillar Plate is 2.183 m. above Copper Spike
 15. Diff. Ht. PM 57931 is 0.076 m. above Copper Spike
 16. Diff. Ht. is m. above/below

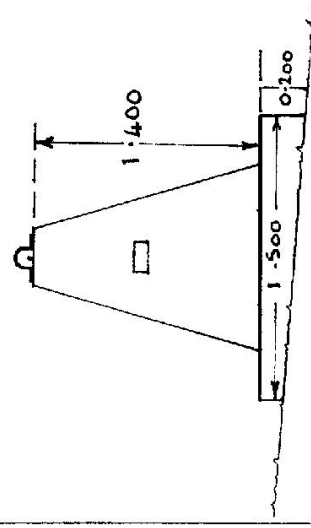

Date: 30/5/86
 Record of Station
 NEW SOVEREIGN CONG. PILLAR PLACED.
 OLD PILLAR TO BE REMOVED BY CLARRY OPERATIONS
 28/5/87 STATION BE NAMED CHAIN OF PONDS

Prepared by: H. C. BORDEE
 Checked: David Thomas

TS 10879


STATIONTS

CHANGING OF RECORDS (C)

Owners Name: Current Occupant:

Address:

11-6-1986 THE
 Access From the corner of, NORTHERN ROAD & BRADLEY ROAD. KM
 (U.B.D Map 58D.J2.) 0.00
 follow along BRADLEY Rd. towards the west.
 Turn right into WEARERS QUARRY. 0.75
 follow road past Office & Weight Bridge. 0.90
 " " towards Quarry, bearing left.
 Turn left onto track before Quarry pit. 1.30
 (track follows S.W. direction.)
 Continue along track to locked gate. 1.75
 (LANDS DEPT. LOCK ON GATE
 or KEY at Quarry Office.)
 follow track S.E. from gate to top of hill.
 CONCRETE OBSERVING PILLAR 2.25

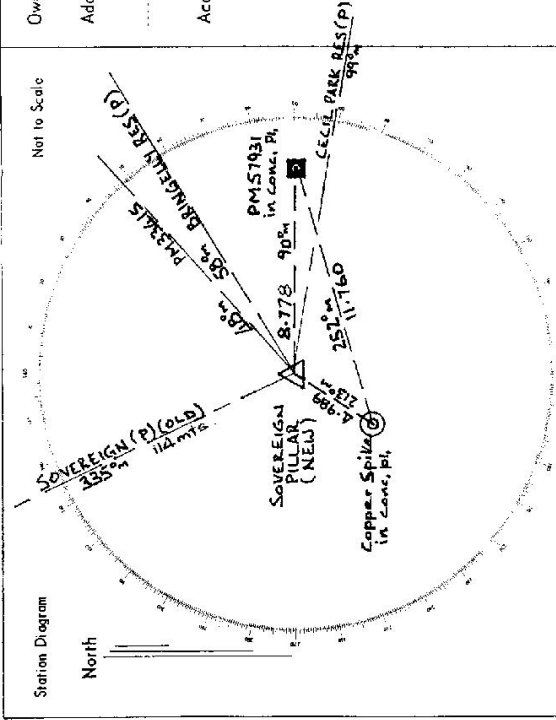

List of Observed Directions:-

Station		Station		Station	
Direction	Direction	Direction	Direction	Direction	Direction
BRINGELLYE Rd (P)	0 00	BRINGELLYE Rd (P)	0 00	BRINGELLYE Rd (P)	0 00
CECIL PARK Rd (P)	32 04	CECIL PARK Rd (P)	43 25	CECIL PARK Rd (P)	43 43
COPPER SPIRE	146 30	COPPER SPIRE	189 26	COPPER SPIRE	189 26
SOVEREIGN (P) OLD	278 26	SOVEREIGN (P) NEW	212 08	SOVEREIGN (P) NEW	212 08
SOVEREIGN (P) NEW	351 37	SOVEREIGN OLD	214 37	SOVEREIGN OLD	214 37
PM 33415	351 37	PM 33415	351 02	PM 33415	351 02

D. West, Government Printer, New South Wales - 1976