


Department of Lands Integrative Survey of N.S.W. TS 10884
RECONNAISSANCE and MAINTENANCE REPORT

STATION CHAUNCY TS-10884

Co: COOPER Ph: JOMAPYAN
 Map Sheet: GRIFFITH 1:25000 No: 8129-3-N
 Inspected by: J. TAYLOR Date: 11-9-87
 Authority: C.L.O. (KARRANDERRA) Field Book:

Beacon Diagram Not to Scale

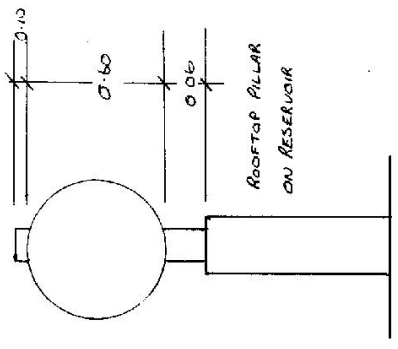

This Trig. Station has been:- Note: Cross out word or words which do not apply

1. Completely cleared to permit 360° vision to surrounding Trigs. ✓
2. Cleared by lanes bearing..... ✓
3. Trig. Mast & Vanes have been painted white & black respectively. ✓
4. The Trig. was unpiled/not unpiled, dimensions now being:

Description of mark..... *ROCK TOP* should be explicit, e.g. Steel plug, Brass plug, Bolt, Concrete Pillar
 Height of mark..... m ^{above} rock, concrete m ^{below} G.L.
 Height of Top Vanes to Top Mark/Top pillar plate... *0.6* m Diameter of Vanes (vertical) *0.60* m.
 Height of Cairn..... m. Diameter of Cairn..... m.

- Length of Mast..... m. (approximate if not unpiled)
5. A..... set in conc/rock has been placed/fd m. bearing°M from Trig. Mast/pillar
 6. A..... set in conc/soil has been placed/fd m. bearing°M from Trig. Mast/pillar
 7. A..... set in conc/soil has been placed/fd m. bearing°M from Trig. Mast/pillar
 8. A..... set in conc/rock has been placed/fd m. bearing°M from Trig. Mast/pillar

9. Connection..... to..... m. bearing.....°M
10. Connection..... to..... m. bearing.....°M
11. Connection..... to..... m. bearing.....°M
12. Connection..... to..... m. bearing.....°M
13. Diff. Ht. is m. ^{above} below
14. Diff. Ht. is m. ^{above} below
15. Diff. Ht. is m. ^{above} below
16. Diff. Ht. is m. ^{above} below

Prepared by: J. TAYLOR Checked: K. LANDER

| Date | Record of Station |
|---------|----------------------------------------------------------------------------------------------------------------------------------------------------|
| 11-9-87 | JAMES & VANES ERECTED ON NEW STATION. |
| | * NOTE: DEPT OF AVIATION HAS REQUESTED THAT THE MAST FOR THIS STATION BE REDUCED TO A MINIMUM. ALL REPLACEMENT MASTS ARE TO BE AS INDICATED ABOVE. |

