




STATION LOCKWOOD TS 10885

Owners Name.....  
Current Occupant.....

Address.....  
Address.....

Access 11-9-1987  
 O.O GRIFFITH POST OFFICE . FOLLOW BANNA AVE. EAST.  
 O-7 TURN LEFT INTO McARTHUR ST. FOLLOW AIRPORT SIGNS.  
 2:2 TURN RIGHT INTO MALLINSON ST.  
 2:3 TURN RIGHT INTO REMEMBRANCE DRIVEWAY.  
 2:7 WATERTOWERS ON LEFT. (TRIC. STATION ON LARGEST WATERTOWER)

NOTE: KEY OBTAINED FROM P.W.D. GRIFFITH (069 626622)  
 #/OR GRIFFITH CITY COUNCIL (069 621277)

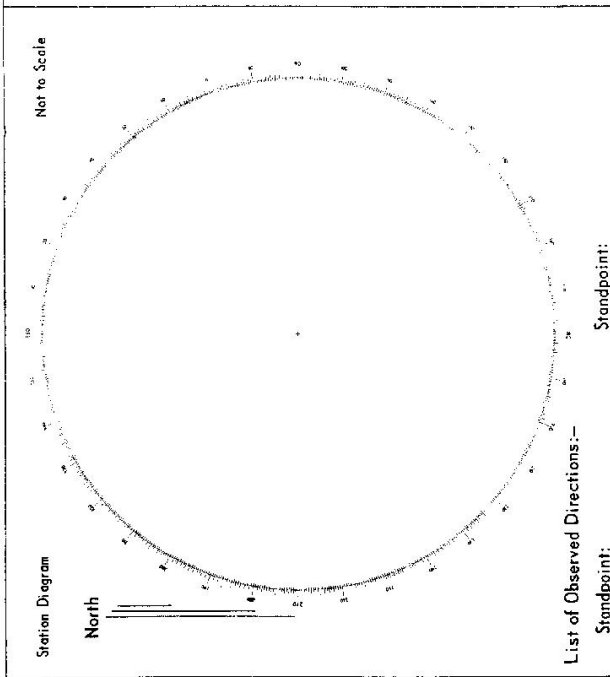

List of Observed Directions:-

Standpoint:	
Station	Direction

D. West, Government Printer, New South Wales - 1976