

CENTRAL MAPPING AUTHORITY

GEODETTIC SURVEY OF N.S.W.

GEODETTIC STATION RECONNAISSANCE and MAIN FENANCE REPORT

STATION: **TUROSS RES (P)** No.: **TS 10887**

MAP SHEETS **BEGA** SCALE 1:100 000
SCALE 1:250 000 **NAROOMA**

INSPECTED BY: **A. Sivertsen** DATE: **28.10.87**

AUTHORITY: **CMA** FIELD BOOK: **R449**

Description: **360°** Note: Cross out word or words which do not apply

1. Cleared by lanes bearing..... **360°** from Trig. Mast

2. Mast & Vanes have been painted white & black respectively. ✓

3. The station/pillar was unpiled/not unpiled/constructed on..... **19**....., dimensions now being:

Description of mark..... should be explicit, e.g., S/Steel Pillar Plate, Steel plug, Brass plug, Bolt, G.I. Pipe

Height of mark..... **1.3**..... m. ^{above} **Steel Platform** _{below} **rock** Mark is..... m. ^{above} G.L. _{below}

Height of Top Vanes to Top Mast/Pillar plate..... **1.390**..... m. Diameter of Vanes (vertical)..... **0.59**..... m.

Height of Cairn..... in. Diameter of Cairn..... m. Name Plate ~~found~~/not found/~~found~~.

Length of Mast..... m. (approximate if not unpiled)

4. A..... **marks** set in conc./rock has been placed/ found, bearing..... °M from Mast/Plug/Pillar

5. A..... **with brass** set in conc./rock has been placed/ found, bearing..... °M from Mast/Plug/Pillar


6. A **NO**..... set in conc./rock has been placed/ found, bearing..... °M from Mast/Plug/Pillar


7. A..... set in conc./rock has been placed/ found, bearing..... °M from Mast/Plug/Pillar

8. Action required:.....

| STANDPOINT: | | STANDPOINT: | | STANDPOINT: | | STANDPOINT: | |
|-------------|-----------|-----------------|-------------------|-------------|-----------|-----------------|-------------------|
| Mark | Direction | Horiz. Distance | Height Difference | Mark | Direction | Horiz. Distance | Height Difference |
| | | | above standpt | | | | above standpt |
| | | | below standpt | | | | below standpt |
| | | | above standpt | | | | above standpt |
| | | | below standpt | | | | below standpt |
Prepared by: *[Signature]* Checked: *[Signature]* **Noted on U.T.M. Card**

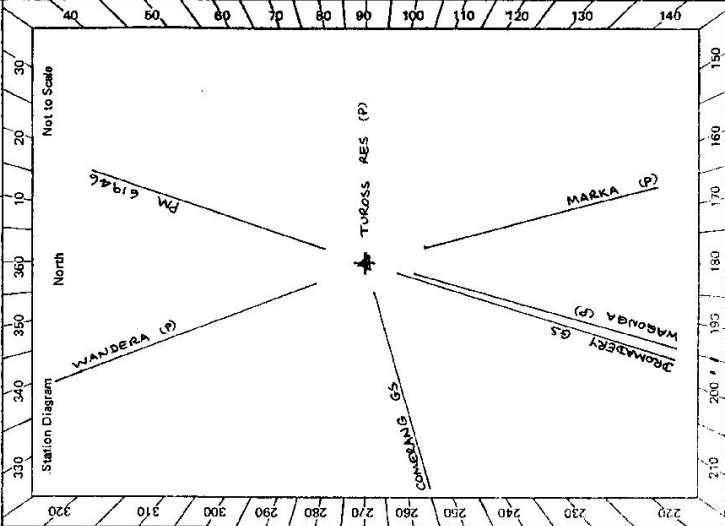
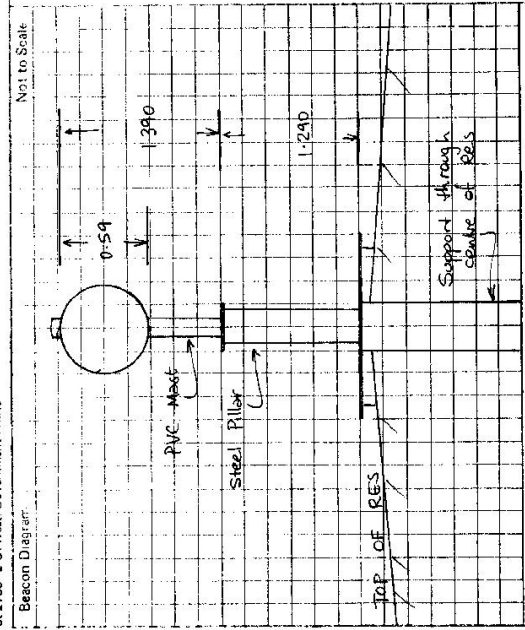
| | |
|--|---|
| <p>STATION TUROSS RES (T) TS 10887</p> <p>Owner's Name EUROBODALLA SHIRE Address MOEUYA Phone:</p> <p>Current Occupant:</p> <p>Address:</p> <p>Phone:</p> <p>ACCESS: Access Report of 28/10/15 was found suitable/unsuitable.</p> <p>For KEY to locked door at reservoir: -</p> <p>MOEUYA Mr. Mark Holmes (surveyor) Shire office Moeuya</p> <p>TUROSS HD Mr. Bill Seymour 37 Jutland Rd Turross Head. (or at works depot adjacent to reservoir)</p> |  <p>Beacon Diagram: Not to Scale</p> <p>This section to be completed by officer constructing pillar.</p> <p>Original station mark found/not found.</p> <p>Description of mark:</p> <p>Original beacon found/not found.</p> <p>Description of beacon:</p> <p>Height Top of Vanes to Top Mark:m.</p> <p>Height of mark:m. above rock/concm. below G.L.</p> <p>Diameter of Vanes:m. Height of Cairn:m.</p> <p>Original Beacon has/has not been destroyed by me.</p> |
| <p>Date</p> | <p>Record of Station</p> |

