

CENTRAL MAPPING AUTHORITY

GEODETIC SURVEY OF N.S.W.

GEODETIC STATION RECONNAISSANCE and MAINTENANCE REPORT

Description: *Note: Cross out word or words which do not apply*

1. Cleared by lanes bearing **All Directions** from Trig. Mast
 2. Mast & Vanes have been painted white & black respectively. No Mast & Vanes at this stage
 3. The station/pillar was ~~erected~~ **erected** on **Apr. 1989**, dimensions now being: **CONCRETE PILLAR** should be explicitly e.g. S/Steel/Pillar/Plate, Steel-Plug, Brass-Plug, Bolt, G.I. Pipe
- Description of mark: **STEEL PILLAR** above rock/concrete; **Mark is** above below
- Height of mark: **1.0** m. above below
- Height of Top Vanes to Top Mark/Pillar plate **0.0** m. Diameter of Vanes (vertical) **0.0** m.
- Height of Cairn: **0.0** m. Diameter of Cairn **0.0** m. Name Plate found/not found/placed.
- Length of Mast **0.0** m. (approximate if not unpiled)
4. **MASS** Δ set in conc/rock has been placed/found, bearing **216° 40' 50"** from Mast/Plug/Pillar **2.454** m
 5. **MASS** Δ set in conc/rock has been placed/found, bearing **217° 11' 15"** from Mast/Plug/Pillar **5.112** m
 6. **MASS** Δ set in conc/rock has been placed/found, bearing **263° 16' 15"** from Mast/Plug/Pillar **3.265** m
 7. **A** set in conc/rock has been placed/found, bearing **0.0** M from Mast/Plug/Pillar

8. Action required: **Formal Approval from Body Corporate. Call to erect M.A. Vanes. required**


Mark	Direction	Horiz. Distance	Height Difference	Mark	Direction	Horiz. Distance	Height Difference
CHATSWOOD [P]	0° 00' 00"			WAHROONGA TS	0° 00' 00"		
CENTREPOINT	27° 36' 08"			TS 10891 [P]	49° 44'	2.454	
TS 10144 [BT]	98° 44' 10"	2454	above standpt.	CHATSWOOD [P]	130° 56' 10"		
BT	99° 15' 15"	5.112	above standpt.	BT	230° 41' 30"		
BT	145° 20' 15"	3.265	above standpt.	BT	324° 46'		
			below				
			below				
STANDPOINT: [P]

STANDPOINT: BT (Old Trig)

Prepared by: **Agreem (RTA)** Checked: **Checked**

Sr 2733-1

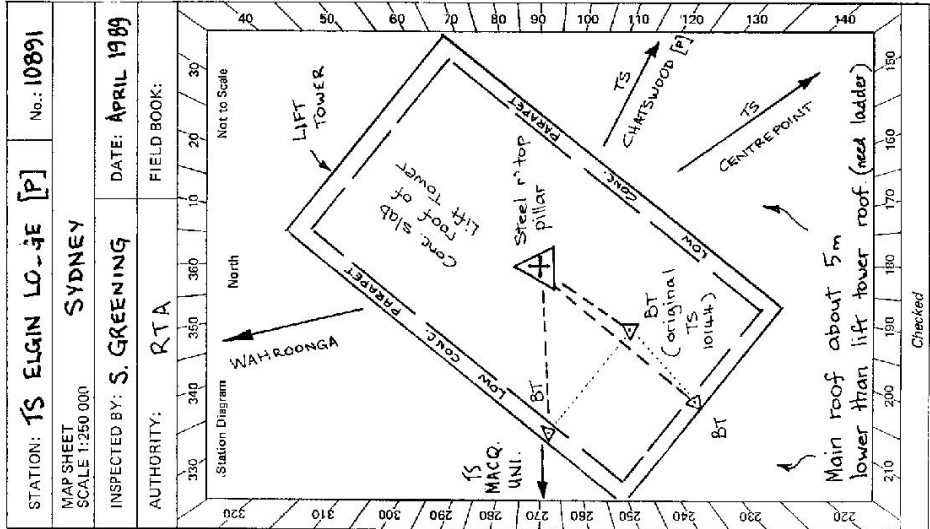


STATION: **TS ELGIN LO-4E [P]** No.: **10891**

MAP SHEET SCALE 1:250 000 **SYDNEY**

INSPECTED BY: **S. GREENING** DATE: **APRIL 1989**

AUTHORITY: **RTA** FIELD BOOK:

Station Diagram North Not to Scale

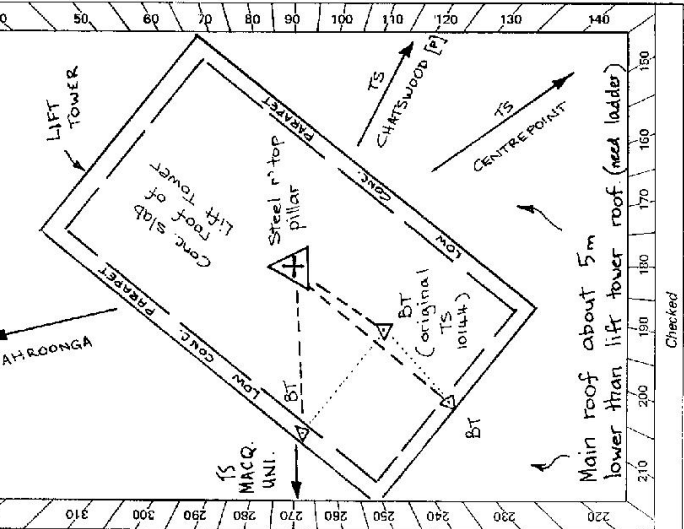

Checked

