

CENTRAL MAPPING AUTHORITY

Trigonometrical Survey of N.S.W.

Department of Lands

RECONSTRUCTION and MAINTENANCE REPORT

This Trig. Station has been:-

Note: Cross out word or words which do not apply

1. Completely cleared to permit 360° vision to surrounding Trigs.
2. Cleared by lanes bearing..... from Trig. Mast
3. Trig. Mast & Vanes have been painted white & black respectively.
4. The Trig. was unpiled/not unpiled, dimensions now being: NEWCASTLE STRAIGHT

Description of mark: Steel Pipe should be explicit, e.g. Steel plug, Brass plug, Bolt, G.I. Pipe

Height of mark: 1.42 m above vertical..... m above/below G.L.

Height of Top Vanes to Top Mark: 1.57 m. Diameter of Vanes (vertical)..... m.

Height of Cairn..... m. Diameter of Cairn..... m.

Length of Mast..... m. (approximate if not unpiled)

5. A..... set in conc/rock has been placed..... m. bearing.....°M from Trig. Mast
6. A..... set in conc/soil has been placed..... m. bearing.....°M from Trig. Mast
7. A..... set in conc/soil has been placed..... m. bearing.....°M from Trig. Mast
8. A..... set in conc/rock has been placed..... m. bearing.....°M from Trig. Mast

9. Connection..... to..... m. bearing.....°M

10. Connection..... to..... m. bearing.....°M

11. Connection..... to..... m. bearing.....°M

12. Connection..... to..... m. bearing.....°M

13. Diff. Ht. Top of Mast is 2.70 m. above.....

14. Diff. Ht. is..... m. above.....

15. Diff. Ht. is..... m. below.....

16. Diff. Ht. is..... m. above.....

Prepared by: _____

Checked: _____

Noted on U.T.M. Card

STATI TS10892

Co: Cox

Ph: Andrew

Map Sheet:

No: _____


Inspected by: J. Pittendrigh

Date: June 87

Authority Water Board

Field Book: PC-7104

Beacon Diagram

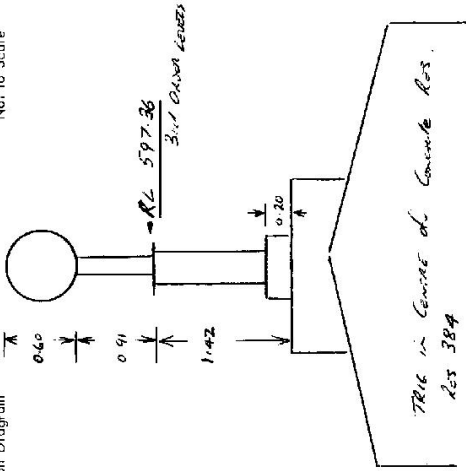

Date

Record of Station

Checked

