

LAND INFORMATION CENTRE

GEODETIC SURVEY OF A.S.M.

GEODETIC STATION RECONNAISSANCE and MAINTENANCE REPORT

STATION: **BAANYA TS** No.: **10893**

MAP SHEET  
SCALE 1:250 000

**BATHURST**


INSPECTED BY: **G. Ford**

DATE: **26-7-95**

AUTHORITY: **L. I. C.**

FIELD BOOK: **---**

- Description:
- Cleared by Janes bearing **360°** Note: Cross out word or words which do not apply  
..... from Trig. Mast
  - Mast & Vanes have been painted white & black respectively. ✓
  - The station/pillar was unspiled/not unspiled/constructed on.....19....., dimensions now being:  
Description of mark: **ROOF TOP PILLAR PLATE** should be explicit, e.g. **S/Steel Pillar Plate, Steel plug, Brass plug, Bot., G.I. Pipe**
  - Height of mark.....m. above rock/concrete; Mark is.....m. above G.L. below
  - Height of Top Vanes to Top Mark/Pillar plate **1.435** m. Diameter of Vanes (vertical).....**0.750** m.
  - Height of Cairn.....m. Diameter of Cairn.....m. Name Plate found/not found/placed.
  - Length of Mast.....m. (approximate if not unspiled)
  - A.....set in conc/rock has been placed/found, bearing.....°M from Mast/Plug/Pillar
  - A.....set in conc/rock has been placed/found, bearing.....°M from Mast/Plug/Pillar
  - A.....set in conc/rock has been placed/found, bearing.....°M from Mast/Plug/Pillar
  - A.....set in conc/rock has been placed/found, bearing.....°M from Mast/Plug/Pillar
  - Action required:.....

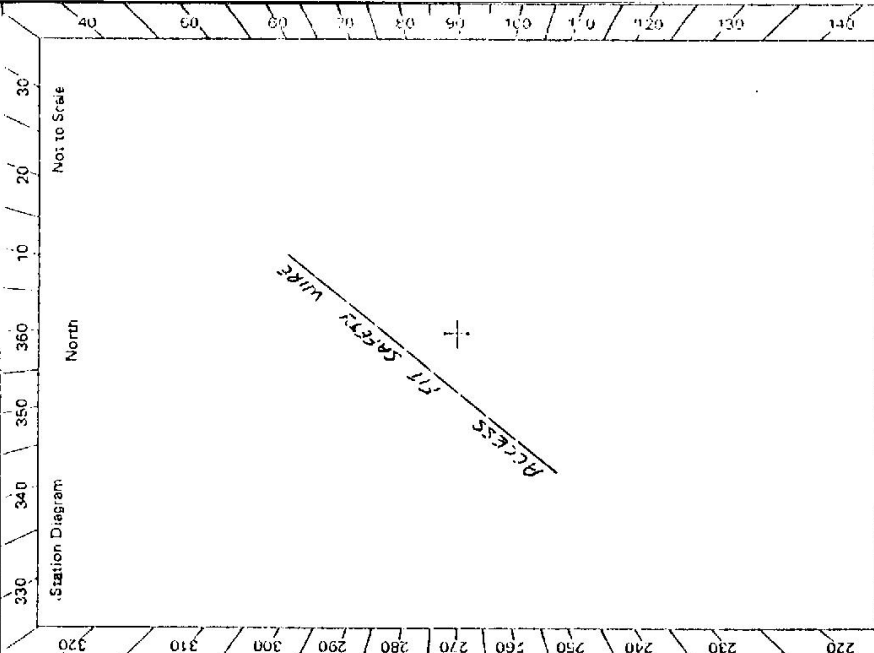

STANDPOINT:				STANDPOINT:			
Mark	Direction	Horiz. Distance	Height Difference	Mark	Direction	Horiz. Distance	Height Difference
			above standpt.				above standpt.
			below				below
			above standpt.				above standpt.
			below				below
Prepared by: **G Ford 28/9/95** Checked: **Noted on U.T.M. Card**

ST 2730 - 2 D. West, Government Printer

STATION **BAA NYA TS 10893**


Owner's Name: **BATHURST CITY COUNCIL**  
 Address: **RUSSELL ST**  
 Phone: **BATHURST 336221**

Current Occupant:  
 Address:  
 Phone:

ACCESS  
 Access Report of ...../19..... was found suitable/unsuitable.

**BAA NYA PILLAR IS ON THE CENTRE OF COUNCIL WATER RES**  
**AT THE TOP END OF NIGHTMARCH PDE OFF SUTTON ST. STEWART.**

**KEY FOR ACCESS RING 336221**  
**LES TOOBY OR ROBERT TAYLOR**  
**SURVEY SECTION**  
**ENGINEERS DEP**  
**BATHURST CITY COUNCIL.**

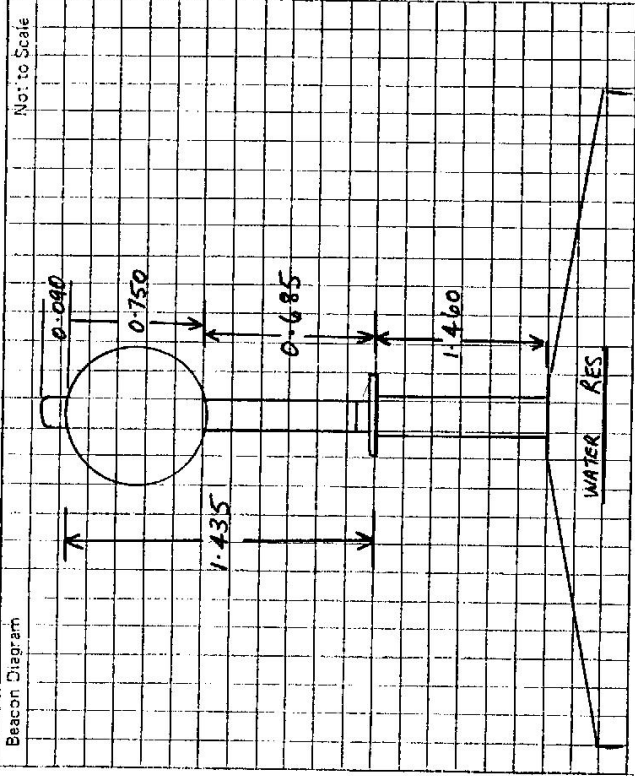

This section to be completed by officer constructing pillar.

Original station mark found/not found.

Description of mark: .....

Original beacon found/not found.

Description of beacon: .....

Height Top of Vanes to Top Mark.....m.

Height of mark.....m. above G.L. below

Diameter of Vanes .....m. Height of Cairn .....m.

Original Beacon has/has not been destroyed by me.

Date	Record of Station
	<i>(REPLACES CONCRETE PILLAR)</i>