

CENTRAL MAPPING AUTHORITY
Department of Lands

Trigonometrical Survey of N.S.W.

RECONNAISSANCE and MAINTENANCE REPORT

This Trig. Station has been:-

Note: Cross out word or words which do not apply

1. Completely cleared to permit 360° vision to surrounding Trigs. ✓
2. Cleared by lanes bearing 360° from Trig. Mast *Flag pole*
3. Trig. Mast & Vanes have been painted white & black respectively.
4. ~~The Trig. was unpiled/ not unpiled, dimensions now being:~~

Description of mark. *Flag pole on Town Hall Spire* should be explicit, e.g. Steel plug, Brass plug, Bolt, G.I. Pipe

Height of mark..... m above below m above below G.L.

Height of Top Vanes to Top Mark..... m. Diameter of Vanes (vertical)..... m.

Height of Cairn..... m. Diameter of Cairn..... m.

Length of Mast..... m. (approximate if not unpiled)

5. A..... set in conc/rock has been placed..... m. bearing.....°M from Trig. Mast
6. A..... set in conc./soil has been placed..... m. bearing.....°M from Trig. Mast
7. A..... set in conc./soil has been placed..... m. bearing.....°M from Trig. Mast
8. A..... set in conc/rock has been placed..... m. bearing.....°M from Trig. Mast

9. Connection..... to..... m. bearing.....°M

10. Connection..... to *Appl*..... m. bearing.....°M

11. Connection..... to..... m. bearing.....°M

12. Connection..... to..... m. bearing.....°M

13. Diff. Ht. is..... m. above below

14. Diff. Ht. is..... m. above below

15. Diff. Ht. is..... m. above below

16. Diff. Ht. is..... m. above below

Prepared by: *R Duff*

Checked:

M. on U.T.M. Card

Checked

STATION T.S. 10897 (Maitland T.H.)


Co: *Northumberland* Ph: *Maitland*

Map Sheet: *Maitland* No: *U4572*

Inspected by: *A.M.J. DUFFY* Date: *27/10/82*

Authority: *C.M.A.* Field Book: *---*

Beacon Diagram Not to Scale

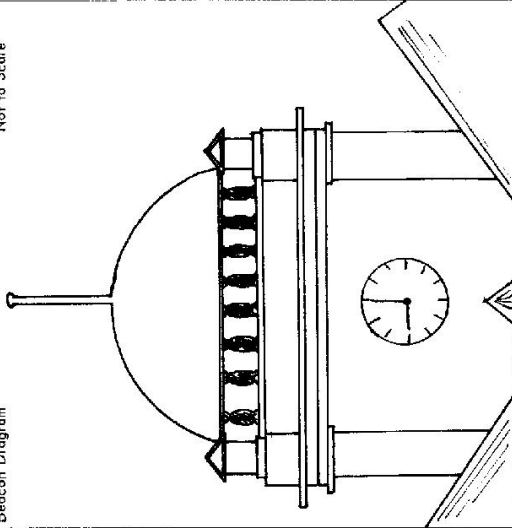

Date Record of Station

*1889 Town Hall & Spire erected.
1982 Diagram drawn.*

