

CENTRAL MAPPING AUTHORITY
Department of Lands

Trigonometrical Survey of N.S.W.

RECONNAISSANCE and MAINTENANCE REPORT

STATION TS 10898 (MAITLAND P.C.)
Co: Northumberland Ph: Maitland
Map Sheet: Maitland U-4572 No: _____
Inspected by: A. Duffy Date: 27/10/88
Authority: C.M.A. Field Book: _____

This Trig. Station has been:-
Note: Cross out word or words which do not apply

1. Completely cleared to permit 360° vision to surrounding Trigs.
2. Cleared by lanes bearing..... Flags from Trig. Mast
3. Trig. Mast & Vanes have been painted white & black respectively.
4. The Trig. was unpiled/hot unpiled, dimensions now being:
Description of mark Flags on Maitland P.C. should be explicit, e.g. Steel plug, Brass plug, Bolt, G.I. Pipe

Height of mark..... m ^{above} rock/concrete _{below} m ^{above} G.L. _{below}
Height of Top Vanes to Top Mark m. Diameter of Vanes (vertical) m.
Height of Cairn m. Diameter of Cairn m.
Length of Mast m. (approximate if not unpiled)


5. A..... set in conc/rock has been placed..... m. bearing..... °M from Trig. Mast
6. A..... set in conc/soil has been placed..... m. bearing..... °M from Trig. Mast
7. A..... set in conc/soil has been placed..... m. bearing..... °M from Trig. Mast
8. A..... set in conc/rock has been placed..... m. bearing..... °M from Trig. Mast

9. Connection..... to..... flag..... m. bearing..... °M
10. Connection..... to..... flag..... m. bearing..... °M
11. Connection..... to..... flag..... m. bearing..... °M
12. Connection..... to..... flag..... m. bearing..... °M
13. Diff. Ht. is..... m. ^{above} _{below}
14. Diff. Ht. is..... m. ^{above} _{below}
15. Diff. Ht. is..... m. ^{above} _{below}
16. Diff. Ht. is..... m. ^{above} _{below}

Prepared by: A.D. 10 Checked: _____

N. Jan U.T.M. Card

Checked

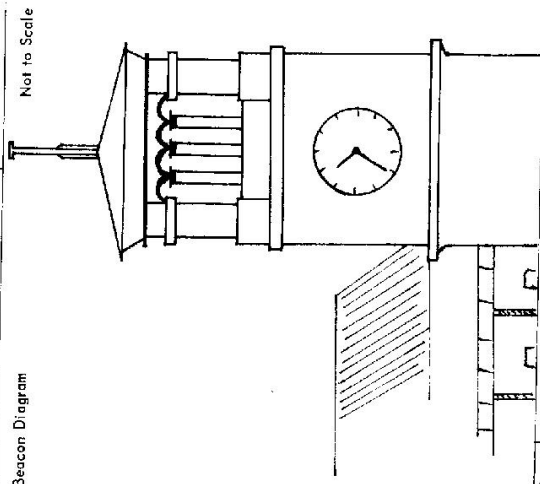

Date: 1988 Record of Station: Diagram drawn

