


STATION BODING PN TS 5278

Owners Name.....
 Current Occupant.....
 Address.....
 Address.....

Access 11-4-75
 Trig is on Great Western Highway at Bodington Hill
 Wentworth Falls. Access is via Kings tableland Rd.

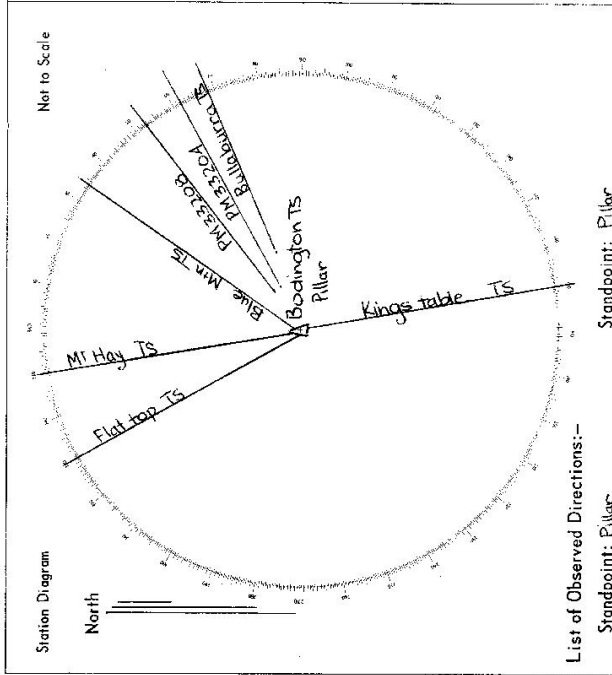

List of Observed Directions:-

Standpoint: Pillar		Standpoint: Pillar	
Station	Direction	Station	Direction
Kings table TS	0° 00' 00"	Bullaburra TS	0° 00' 00"
PM33204	260° 59' 54.7"	Flat top TS	74° 29' 41.5"
Bullaburra TS	263° 53' 34.2"	Mt Hay TS	286° 34' 41.3"
		Blue Mountain TS	331° 08' 47.2"
		PM33705	349° 04' 16.0"
Station	Direction	Station	Direction

CENTRAL MAPPING AUTHORITY
 GEODETIC SURVEY OF N.S.W. Batch ID: 1604
 GEODETIC STATION RECONNAISSANCE and MAINTENANCE REPORT

Description:

1. Cleared by lanes bearing.....
 Note: Cross out word or words which do not apply

2. Mast & Vanes have been painted white & black respectively,
 from Trig. Mast

3. The station/pillar was unpiled/not unpiled/constructed on.....19....., dimensions now being:

Description of mark.....should be explicit, e.g., S/Steel Pillar Plate, Steel plug, Brass plug, Bolt, G.I. Pipe

Height of mark.....m. above rock/concrete; Mark is.....m. above G.L.

Height of Top Vanes to Top Mark/Pillar plate.....m. Diameter of Vanes (vertical).....m.

Height of Cairn.....m. Diameter of Cairn.....m. Name Plate found/not found/placed.

Length of Mast.....m. (approximate if not unpiled)

4. A...PM 54483...set in conc/rock has been placed/removed, bearing...36...°M from Mast/Plug/Pillar

5. A...PM 54537...set in conc/rock has been placed/removed, bearing...310...°M from Mast/Plug/Pillar

6. A.....set in conc/rock has been placed/removed, bearing.....°M from Mast/Plug/Pillar

7. A.....set in conc/rock has been placed/removed, bearing.....°M from Mast/Plug/Pillar

8. Action required:.....

STANDPOINT: Pillar Plate

STANDPOINT: PM 54483


Mark	Direction	Horiz. Distance	Height Difference	Mark	Direction	Horiz. Distance	Height Difference
FLAT TOP (P)	0°00'00"		above standpt.	BAYE MOUNTAIN (P)	0°00'00"		above standpt.
BAYE MOUNTAIN (P)	72°39'51.0"		above standpt.	BODDINGTON (P)	165°21'22"	24.336	18.607
PM 54483	58°04'32"	24.340	above standpt.	PM 54537	211°21'37"	32.852	1.746
PM 54537	331°44'11"	23.690	below standpt.				
			above standpt.	STANDPOINT: PM 54537			
			below standpt.	PM 54483	12°19'10"	32.859	1.748
			above standpt.	BODDINGTON (P)	57°58'16"	23.685	16.959
			below standpt.				

Prepared by: Kenneth

Checked:

Noted on U.T.M. Card 14A 202185

Checked 14A

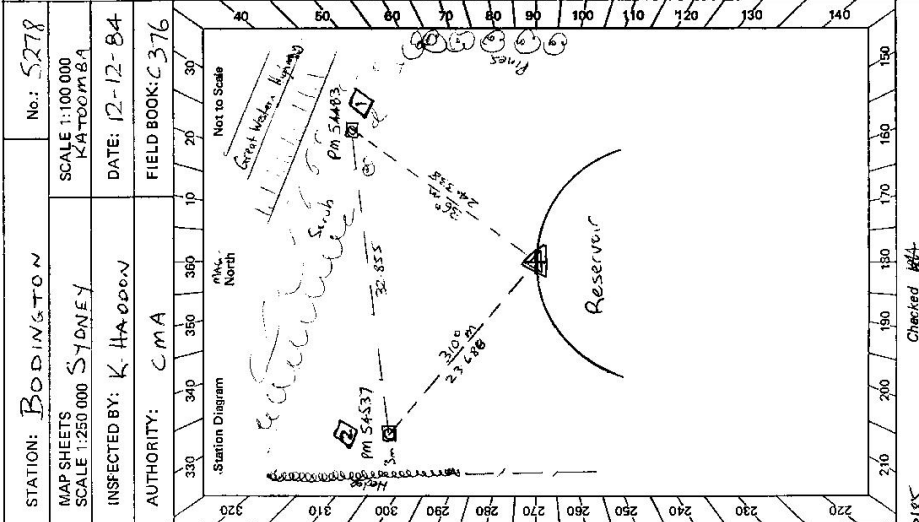

Department of Lands

RECONNAISSANCE and MAINTENANCE REPORT

STATION O.T.S. 5278 BODINGTON

10911

This Trig. Station has been:-


Note: Cross out word or words which do not apply

1. Completely cleared to permit 360° vision to surrounding Trigs.
 2. Cleared by lanes bearing from Trig. Mast
 3. Trig. Mast & Vanes have been painted white & black respectively.
 4. The Trig. was unpiled/not unpiled, dimensions now being: Original Station Mark found / not found
- Description of mark: **STEEL PILLAR** should be explicit, e.g. Steel plug, Brass plug, Bolt, G.I. Pipe
- Height of mark: 1.42 m ^{above} ~~below~~ **PLATFORM** ^{above} ~~below~~ G.L.
- Height of Top Vanes to Top Mark: 1.55 m. Diameter of Vanes (vertical) m.
- Height of Cairn m. Diameter of Cairn m.
- Length of Mast m. (approximate if not unpiled)
5. A. set in conc/rock has been placed. m. bearing ^{9M} from Trig. Mast
 6. A. set in conc/soil has been placed. m. bearing ^{9M} from Trig. Mast
 7. A. set in conc/soil has been placed. m. bearing ^{9M} from Trig. Mast
 8. A. set in conc/rock has been placed. m. bearing ^{9M} from Trig. Mast
 9. Connection: to m. bearing ^{9M}
 10. Connection: to m. bearing ^{9M}
 11. Connection: to m. bearing ^{9M}
 12. Connection: to m. bearing ^{9M}
 13. Diff. Ht. TOP OF PILLAR is 32.08 m. ~~above~~ ^{below} P.M. 574.59 R.L. 854.612 (ORIGIN OF LEVELS)
 14. Diff. Ht. is m. ^{above} ~~below~~
 15. Diff. Ht. is m. ^{above} ~~below~~
 16. Diff. Ht. is m. ^{above} ~~below~~

Prepared by: Checked: Noted on U.T.M. Card


Co: COOK	Ph: JAMIESON
Map Sheet:	No:
Inspected by: J. POTTER	Date: JUNE 1990
Authority: WATER BOARD	Field Book:

Beacon Diagram Not to Scale

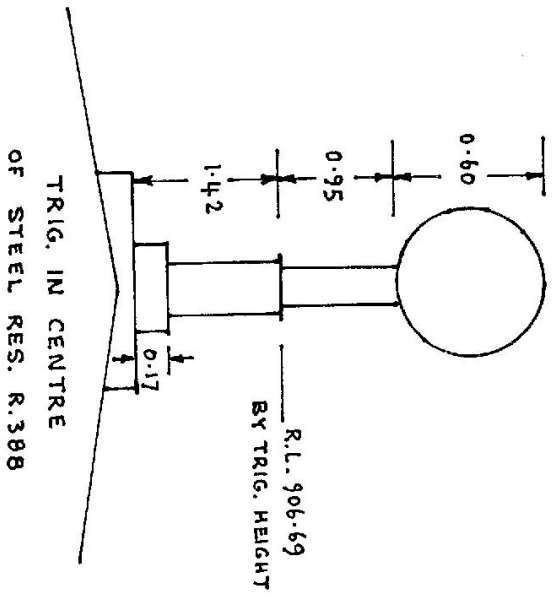

Date	Record of Station

Checked

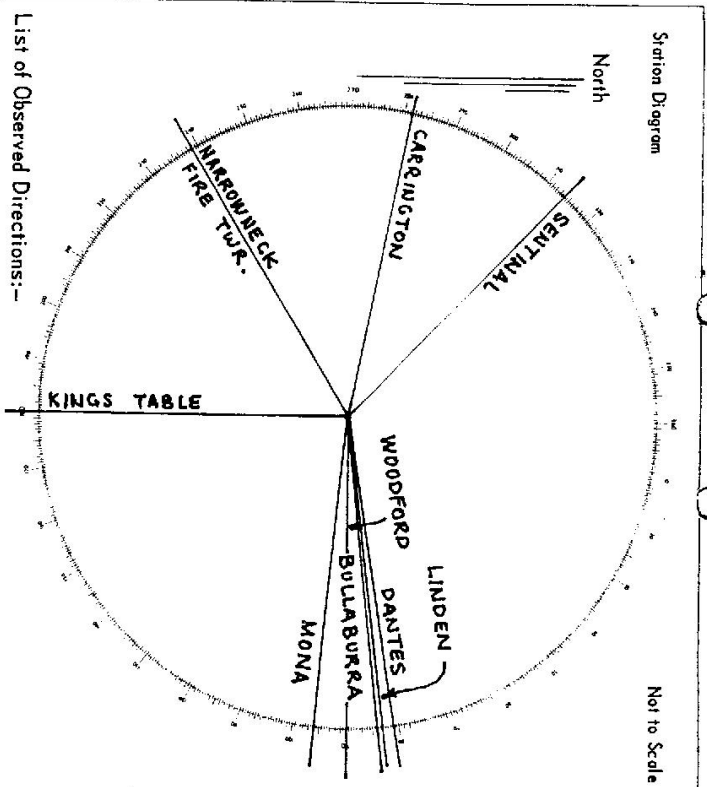

List of Observed Directions:-

Standpoint: PILLAR

Standpoint: PILLAR (CONT'D.)

Station	Direction	Station	Direction
TS 5183 KINGS TABLE	180 12 31	TS 2851 LINDEN	83 55 28
TS 10214 HARBORNECK	239 06 08	TS 10211 BULLABURRA (SIDE)	83 58 45
TS 10132 CARRINGTON	281 24 81	TS 1438 WOODFORD	90 00 50
TS 10267 SENTINAL (SIDE)	314 16 21	TS 10209 MONA (SIDE)	96 26 13
TS 10208 DANTES (SIDE)	01 27 55		

Station	Direction	Station	Direction

Station Diagram

Not to Scale


Owners Name: WATER BOARD

Current Occupant: WATER BOARD

Address:

Address:

Access

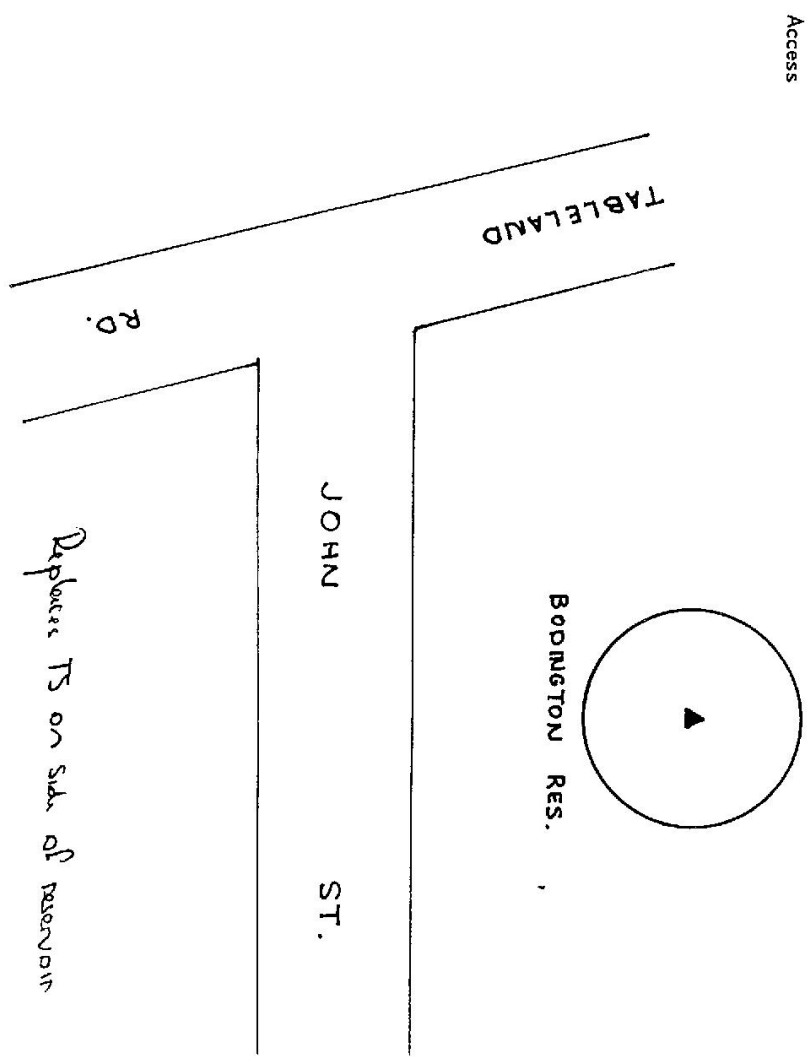

Replaces TS on side of reservoir

10911 STATION T.S. 520 BODINGTON (P) CE