


STATION TS 10369 EMU RES (P)
 Co: COOK Ph: STRATHDON
 Map Sheet: PENINSULA No: D6460-III

Inspected by: J.L. FLETCHER Date: 6.6.77
 Authority: DEPT. OF LANDS Field Book: 512/8

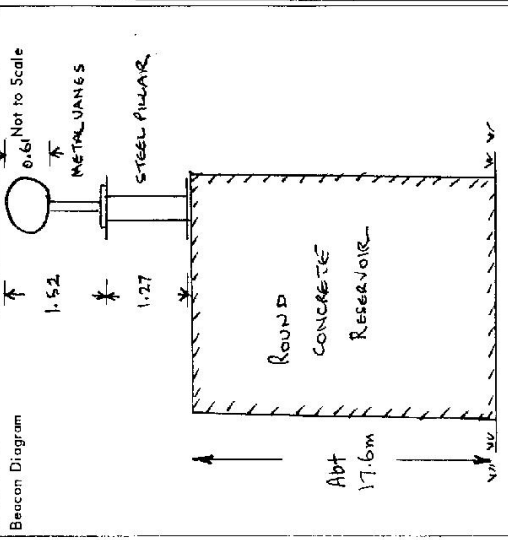

Date	Record of Station
19.1.78	See POP 9163 Page 20.

Department of Lands
 Integral Survey of N.S.W.
 RECONNAISSANCE and MAINTENANCE REPORT

This Trig. Station has been: Note: Cross out word or words which do not apply

1. Completely cleared to permit 360° vision to surrounding Trigs.
2. Cleared by lanes bearing. from Trig. Mast
3. Trig. Mast & Vanes have been painted white & black respectively.
4. The Trig. was unpiled/not unpiled, dimensions now being:

Description of mark: Steel plate on steel pillar should be explicit, e.g. Steel plug, Brass plug, Ball, Concrete Pillar
 Height of mark: Steel plate m above rock concrete Abt 18.8 m above G.L.
 Height of Top Vanes to Top Mark/Top pillar plate: 1.52 m Diameter of Vanes (vertical): 0.61 m.
 Height of Cairn: m. Diameter of Cairn: m.

- Length of Mast: m. (approximate if not unpiled)
5. P.M.H. 5660 set in conc./soil has been placed/fd 28.055 m. bearing 56° 10' 20" from Trig. Mast/pillar
 6. A set in conc./soil has been placed/fd m. bearing °M from Trig. Mast/pillar
 7. A set in conc./soil has been placed/fd m. bearing °M from Trig. Mast/pillar
 8. A set in conc./rock has been placed/fd m. bearing °M from Trig. Mast/pillar

9. Connection to m. bearing °M
10. Connection to m. bearing °M
11. Connection to m. bearing °M
12. Connection to m. bearing °M
13. Diff. Ht. Steel plate is 18.95 m. above P.M.H. 5660
 below
14. Diff. Ht. is m. above
 below
15. Diff. Ht. is m. above
 below
16. Diff. Ht. is m. above
 below

Prepared by: R. S. ... Checked: ...



STATION TS 10369 EMU RES (P)

Owners Name: Blue Mountains City Council Current Occupant

Address: Katamba Address

6-6-1977
 Access At corner of Hodgson Road and Emu Road, Lapstone.
 See UBD Map 45 N 5 (11th edition).

A key is required to gain access to the top of reservoir. It may be obtained from B.H.C.C. Care should be taken climbing up that vertical ladder as there is no safety cage.

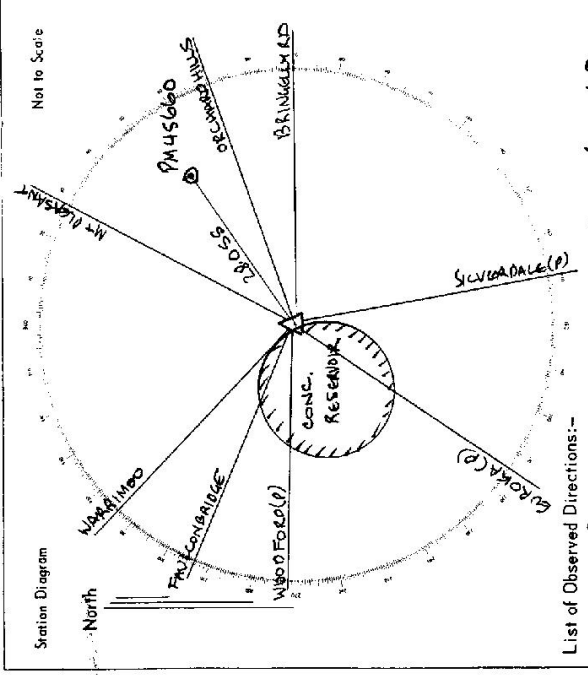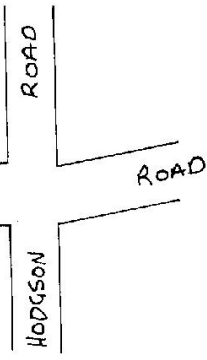

List of Observed Directions:-

Station	Direction	Station	Direction
ORCHARD HILLS	11° 25' 39"	SILVERDALE (P)	169° 59' 31"
BRINKLEY RD	90° 00' 00"	WOODFORD (P)	172° 21' 31"
GURKHA (P)	213° 37' 42"	FRUITSVILLE	233° 37' 14"
WARRIMOO (P)	270° 12' 41"	WARRIMOO	314° 05' 57"
PM45610	316° 10' 20"		

CENTRAL MAPPING AUTHORITY

Department Lands

Trigonometrical Survey of N.S.W.

RECORD OF MAINTENANCE REPORT

STATION T.S. 10369 EMU RES.

This Trig. Station has been:-

Note: Cross out word or words which do not apply

1. Completely cleared to permit 360° vision to surrounding Trigs.
2. Cleared by lanes bearing..... from Trig. Mast
3. Trig. Mast & Vanes have been painted white & black respectively. **NEW STATION**
4. The Trig. was unpiled/not unpiled, dimensions now being: Original Station Mark found not found
Description of mark..... **STEEL PILLAR**..... should be explicit, e.g. Steel plug, Brass plug, Bolt, G.I. Pipe
Height of mark..... ^{above} 1.45 m..... ~~below~~ PLATFORM..... ^{above} G.L. m..... ~~below~~ CONCRETE.....
Height of Top Vanes to Top Mark 1.43 m..... Diameter of Vanes (vertical)..... m.
Height of Cairn..... m..... Diameter of Cairn..... m.
Length of Mast..... m. (approximate if not unpiled)
5. A..... set in conc./rock has been placed..... m. bearing.....°M from Trig. Mast
6. A..... set in conc./soil has been placed..... m. bearing.....°M from Trig. Mast
7. A..... set in conc./soil has been placed..... m. bearing.....°M from Trig. Mast
8. A..... set in conc./rock has been placed..... m. bearing.....°M from Trig. Mast
9. Connection..... to..... m. bearing.....°M
10. Connection..... to..... m. bearing.....°M
11. Connection..... to..... m. bearing.....°M
12. Connection..... to..... m. bearing.....°M
13. Diff. Ht. **TOP OF PILLAR** is 19.91 m..... ^{above} P.M. 45660..... ~~below~~ R.L. 223-824.....
(ORIGIN OF LEVELS)
14. Diff. Ht. is..... m. ^{above}..... ~~below~~.....
15. Diff. Ht. is..... m. ^{above}..... ~~below~~.....
16. Diff. Ht. is..... m. ^{above}..... ~~below~~.....

Prepared by:.....

Checked:.....

Noted on U.T.M. Card


Co: **COOK** Ph: **STRATHDON**

Map Sheet:..... No:.....

Inspected by: **J. POTTER** Date: **JUNE 1990**

Authority: **WATER BOARD** Field Book:.....

Beacon Diagram Not to Scale

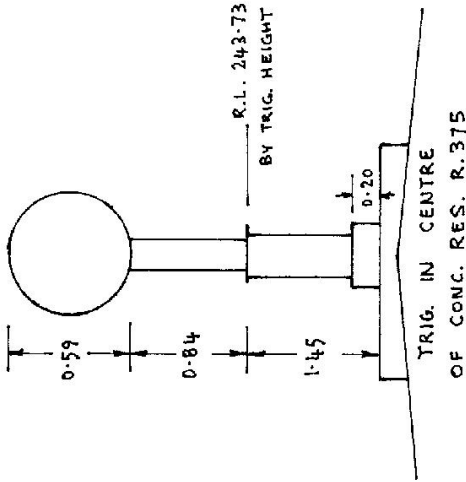

Date..... Record of Station.....

Checked.....

STATION T.S. 10369 EMU RE: (P) CENTRE


Owners Name: WATER BOARD

Current Occupant: WATER BOARD

Address:

Address:

Access June 1990

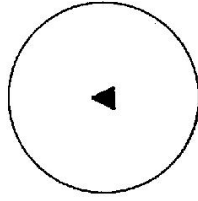

GLENBROOK RES.


EMU

RD.

HODGSON

Diplom TS on side of reservoir

Not to Scale

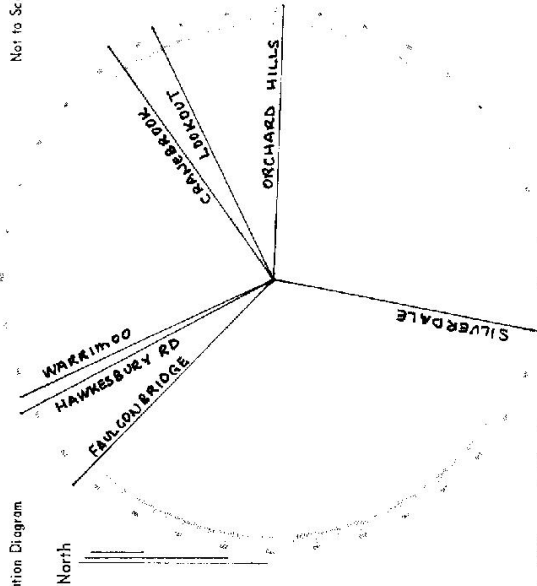

List of Observed Directions:-

Standpoint: PILLAR		Standpoint: PILLAR (CONT'D)	
Station	Direction	Station	Direction
TS 2035 FALCONBRIDGE	314 10 19	TS 3631 ORCHARD HILLS	91 53 07
TS 2436 HAWKESBURY RD	331 53 09	TS 10370 SILVERDALE	190 33 04
TS 4663 WARRIMOO	324 49 06		
TS 10866 CANNESBROOK	54 27 17		
TS 2891 LOOKOUT	63 55 31		

Station	Direction	Station	Direction

Department **roads**

RECONNAISSANCE and MAINTENANCE REPORT

STATION **OTS. 10913 EMU RES.**

This Trig. Station has been:-


Note: Cross out word or words which do not apply

1. Completely cleared to permit 360° vision to surrounding Trigs.
 2. Cleared by lanes bearing..... from Trig. Mast
 3. Trig. Mast & Vanes have been painted white & black respectively.
 4. The Trig. was unplied/not unplied, dimensions now being: **NEW STATION**
Original Station Mark found /not found
- Description of mark: **STEEL PILLAR** should be explicit, e.g. Steel plug, Brass plug, Bolt, G.I. Pipe
PLATFORM
- Height of mark: 1.45 m ^{above} ~~below~~ ~~concrete~~ m ^{above} G.L.
- Height of Top Vanes to Top Mark: 1.43 m. Diameter of Vanes (vertical)..... m.
- Height of Cairn..... m. Diameter of Cairn..... m.
- Length of Mast..... m. (approximate if not unplied)
5. A..... set in conc/rock has been placed..... m. bearing..... M from Trig. Mast
 6. A..... set in conc/soil has been placed..... m. bearing..... M from Trig. Mast
 7. A..... set in conc/soil has been placed..... m. bearing..... M from Trig. Mast
 8. A..... set in conc/rock has been placed..... m. bearing..... M from Trig. Mast
 9. Connection..... to..... m. bearing..... M
 10. Connection..... to..... m. bearing..... M
 11. Connection..... to..... m. bearing..... M
 12. Connection..... to..... m. bearing..... M
 13. Diff. Ht. **Top of pillar** is 19.91 m. ^{above} ~~below~~ **P.M. 45660 R.L. 223.824**
(ORIGIN OF LEVELS)
 14. Diff. Ht. is..... m. ^{above} ~~below~~
 15. Diff. Ht. is..... m. ^{above} ~~below~~
 16. Diff. Ht. is..... m. ^{above} ~~below~~
- Prepared by:..... Checked:..... Noted on U.T.M. Grid

Co: **COOK** Ph: **STRATHDON**


Map Sheet:..... No:.....
Inspected by: **J. POTTER** Date: **JUNE 1990**

Authority: **WATER BOARD** Field Book:.....
Beacon Diagram:..... Not to Scale

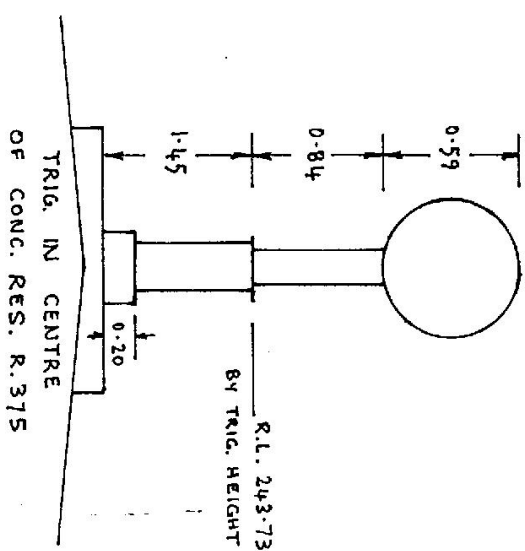

Date	Record of Station

Checked

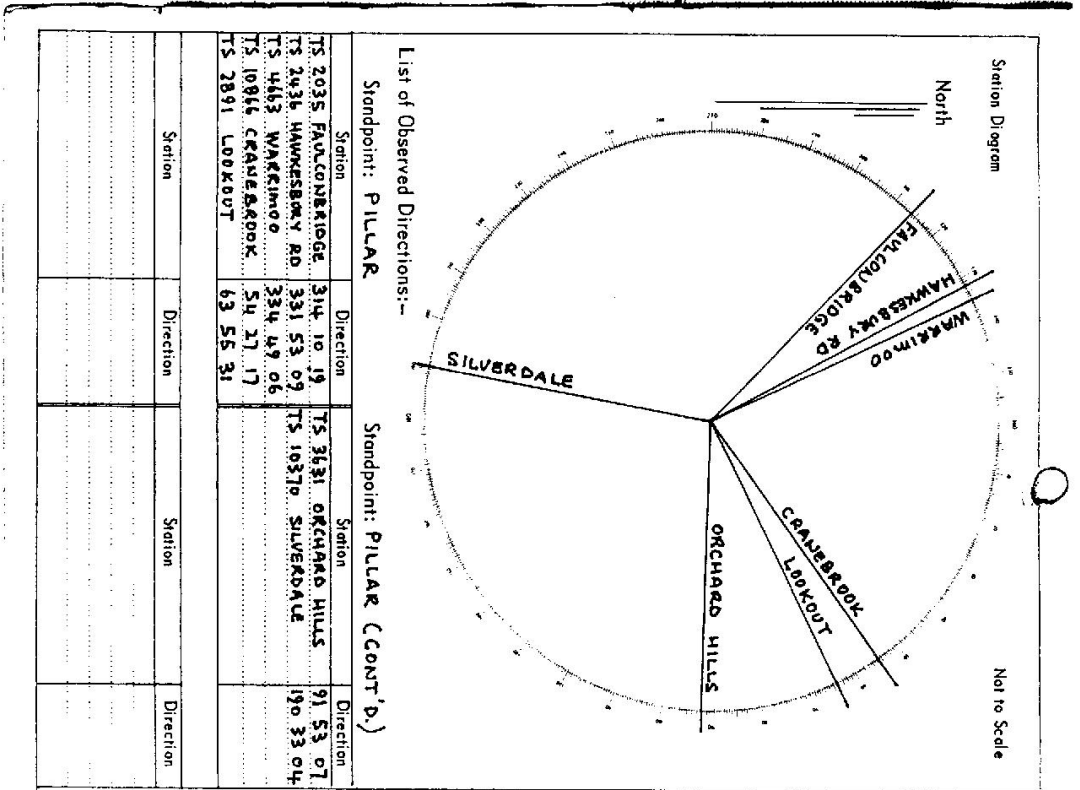

STATION T.S. 10913 EMU RES (P) CENTRE

Owners Name: WATER BOARD
 Address:
 Access June 1990

Current Occupant: WATER BOARD
 Address:

EMU RD.
 HODGSON RD.
 GLENBROOK RES.

Deposits TS on side of reservoir