

**LAND INFORMATION CENTRE**

GEODETTIC SURVEY OF A.S.K.

**GEODETTIC STATION RECONNAISSANCE and MAINTENANCE REPORT**

Description:

1. Cleared by lanes bearing..... See Station Sky Plot..... from Trig. Mast

2. Mast & Vanes have been painted white & black respectively.

3. The ~~station~~ pillar was ~~replaced~~ constructed on 18 April 1991, dimensions now being:

Description of mark: St. Pillar Plate should be explicit, e.g., S/Steel Pillar Plate, Steel plug, Brass plug, Bolt, G.I. Pipe

Height of mark..... 1.380 m. <sup>above</sup> ~~below~~ rock/concrete. Mark is 1.610 m. <sup>above</sup> ~~below~~ G.L.

Height of Top Vanes to Top ~~Mark~~ Pillar plate 1.445 m. Diameter of Vanes (vertical) 0.750 m.

Height of Cairn..... m. Diameter of Cairn..... m. Name Plate found/not found/placed.

Length of Mast 1.545 m. (approximate if not omitted)

4. A..... set in conc/rock has been placed/found, bearing..... °M from Mast/Plug/Pillar

5. A..... set in conc/rock has been placed/found, bearing..... °M from Mast/Plug/Pillar

6. A..... set in conc/rock has been placed/found, bearing..... °M from Mast/Plug/Pillar

7. A..... set in conc/rock has been placed/found, bearing..... °M from Mast/Plug/Pillar

8. Action required:.....

**STANDPOINT:**

Mark	Direction	Horiz. Distance	Height Difference	Mark	Direction	Horiz. Distance	Height Difference
			above standpt.				above standpt.
			below				below
			above standpt.				above standpt.
			below				below
			above				above
			below				below
			above standpt.				above standpt.
			below				below
			above standpt.				above standpt.
			below				below

Prepared by: D. KAIN

Checked: [Signature] 19/4/91 Noted on U.T.M. Card

STATION: ZOOLOGICAL (P) / No.: 10919

MAP SHEET SCALE 1:250 000 Dubbo

INSPECTED BY: D. J. KAIN / DATE: 18.4.91

AUTHORITY: L.I.C. / FIELD BOOK: CO. 511

Station Diagram

Not to Scale

North

NEW STATION,  
NO SATELLITE MARKS  
+ PLACED.

Scaled Coordinates  
Z 55 649300 6427800  
E N

Checked

STATION ZOOLOGICAL RILNE 10919


Owner's Name: **ZOOLOGICAL PARKS BOARD OF N.S.W.**  
 Address: **WESTERN PLAINS ZOO**  
 Phone: **(068) 82 5888**

Owner's Name: **MR TIM LARCEY**  
 Address: **DIPLOCK**  
 Phone: **18-4-1991**

ACCESS **18-4-1991**  
 Access Report of **18-4-1991** was found suitable/unsuitable.

STATION IS SITUATED ON SOUTHERN SIDE  
 OF WATERBIRD LAKE AND NURSERY POND  
 IN DUBBO ZOO.

TS 2733-2 D. West, Government Printer

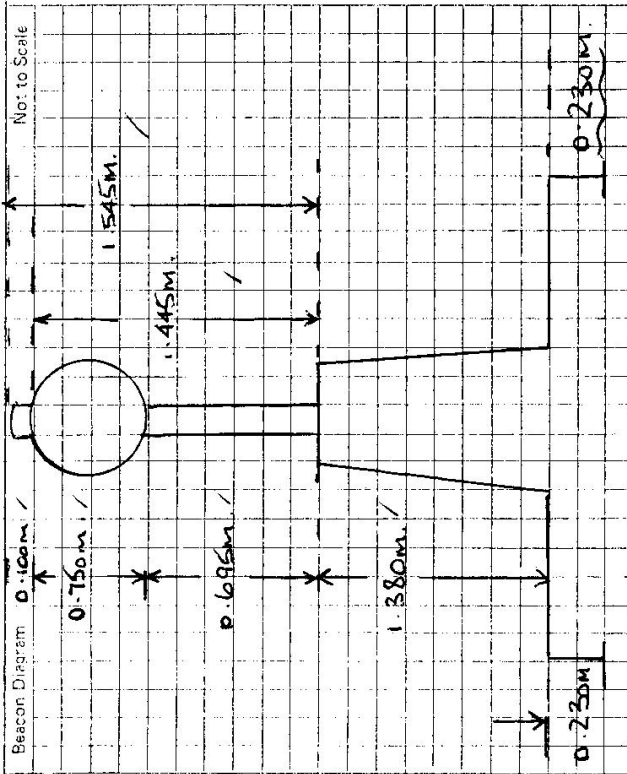

This section to be completed by officer constructing pillar.

Original station mark found/not found.

Description of mark: **NEW STATION**

Original beacon found/not found.

Description of beacon:

Height Top of Vanes to Top Mark: **NEW STATION** m.

Height of mark: **NEW STATION** m. <sup>above</sup> rock/conc. <sup>below</sup> G.L.

Diameter of Vanes: **NEW STATION** m. Height of Cairn: **NEW STATION** m.

Original Beacon has/has not been destroyed by me.

Date

Record of Station