

Department of Lands

Central Mapping Authority

Trigonometrical Survey of N.S.W.

RECONNAISSANCE and MAINTENANCE REPORT on COWELL NEW TRIG. STATION

Parish Manly Cove County Cumberland Map Sheet SYDNEY No. _____

Inspected by C. STARKEY Date of Inspection 22-9-93

This Trig. Station has been:-

Note: Cross out word or words which do not apply

1. Completely cleared to permit 360° vision to surrounding Trigs.
2. ~~Cleared by lanes bearing _____ from Trig. Mast~~
3. The Trig. was unipiled/~~not unipiled~~. dimensions now being:

Original Trig. Plug was found/~~not found~~.

Length of Mast 0.915 ^m ~~feet~~ (approximate if not unipiled)

Mast (Round 0.60 ^m ~~feet~~ diameter
(Square _____ ~~feet~~)

Height of Trig. Plug _____ ~~feet~~ (above rock/concrete)

Height of Top Vanes to Top Trig. Plug 0.915 ^m ~~feet~~

Diameter of Vanes (vertical) _____ ~~feet~~

~~Height of Cairn _____ feet~~

~~Diameter of Cairn _____ feet~~


(If other type Trig. beacon is erected - Diagram is required below in Remarks)

4. Trig. Mast & Vanes have been painted white & black respectively.
5. ~~An S.S.M. set in conc/rock has been placed _____ feet bearing _____° M to Trig. Mast/Plug~~
6. ~~A G.I. Pipe set in conc/soil has been placed _____ feet bearing _____° M to Trig. Mast/Plug~~
7. ~~Connection S.S.M. to G.I. Pipe _____ feet bearing _____° M~~

REMARKS:- (To include diagram of marks placed)

North

TS 10929

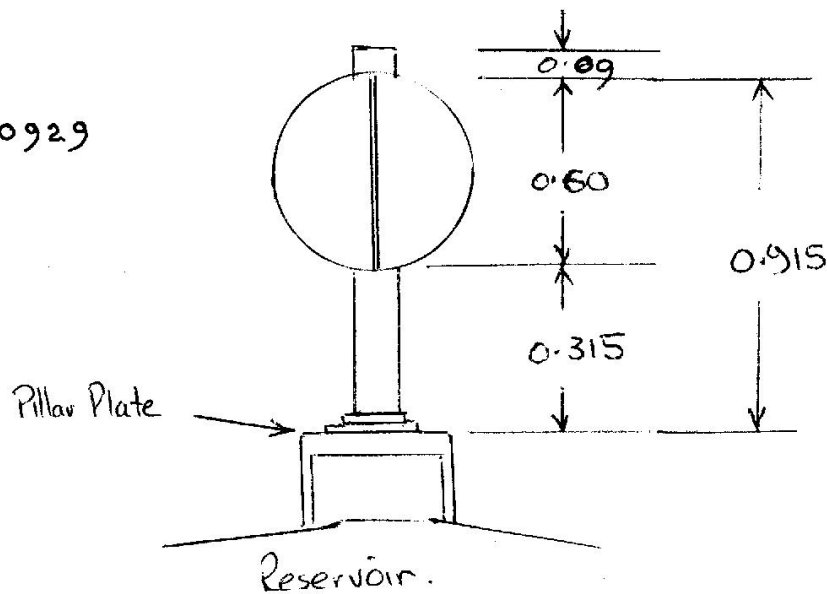

Access : 22-9-93
TS 10929 COWELL NEW

