

" ROYAL REHABILITATION CENTRE "


TS 10930
"WEEMALA"

LOCATION: CNR PRINCES ST.
& MORRISON RD., PUTNEY

~~DESCRIPTION:~~

DESCRIPTION: LIGHTNING ROD
ON HIGHEST
PART OF WHITE
HOSPITAL BUILDING

LOCALITY SKETCH PLAN

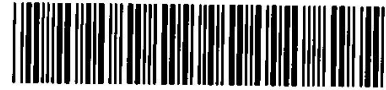


TS10930

Office Use - Barcode Including Number Inserted Here

Local Government Area ... Ryde
 Town/Suburb/Locality Ryde
 Approx MGA Coordinate: Zone.....
 E:
 N:

Description of Mark **Lightning Rod on Highest part of white Hospital Building**

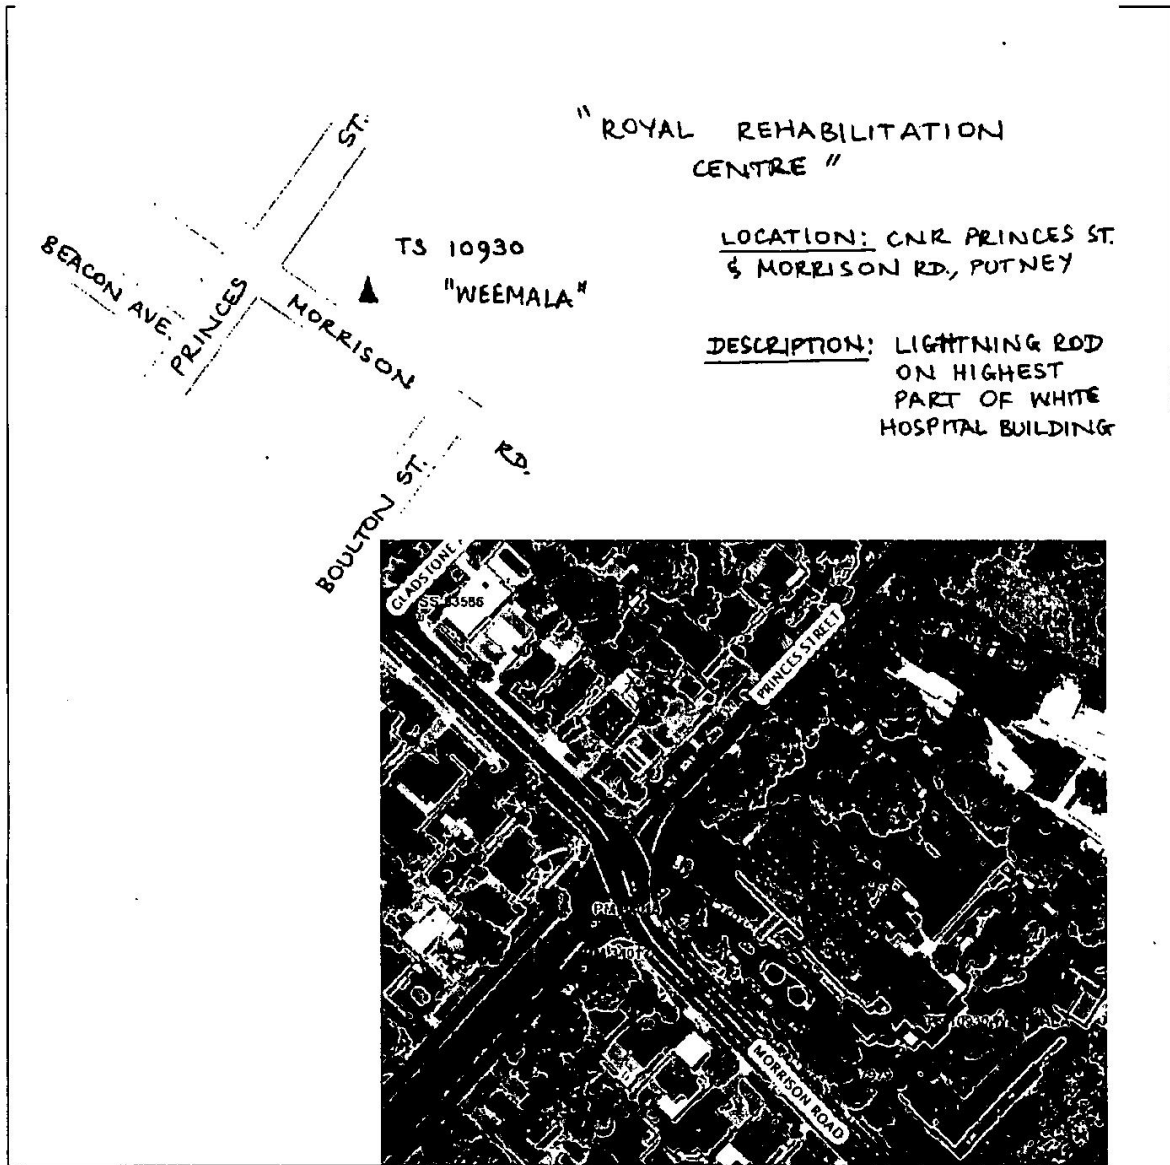

Please use black ink only

SURVEYING REGULATION			
MARK	AHD	SOURCE	DATE
HEIGHT DETERMINED BY - DIFF. LEVELLING (Specify) - TRIG HEIGHTING ADOPTED MARKS - GPS			

Measurements are in metres

I certify that the mark has been placed/found and numbered as detailed hereon.

TS 10930
Weemala

Signed:

Name:

Organisation placing mark:

PM

Date mark placed/found: / /

Replaces

SS

Ref: