

**LAND INFORMATION CENTRE**

GEODETTIC SURVEY OF N.S.W.


**GEODETTIC STATION RECONNAISSANCE and MAINTENANCE REPORT**

STATION: **COMERFORDS RES** No.: **10950**

MAP SHEET SCALE 1:250 000 **MAITLAND** 1: 25 000

INSPECTED BY: **P. O'KANE** DATE: **20/6/94**

AUTHORITY: **SCB Newcastle** FIELD BOOK:

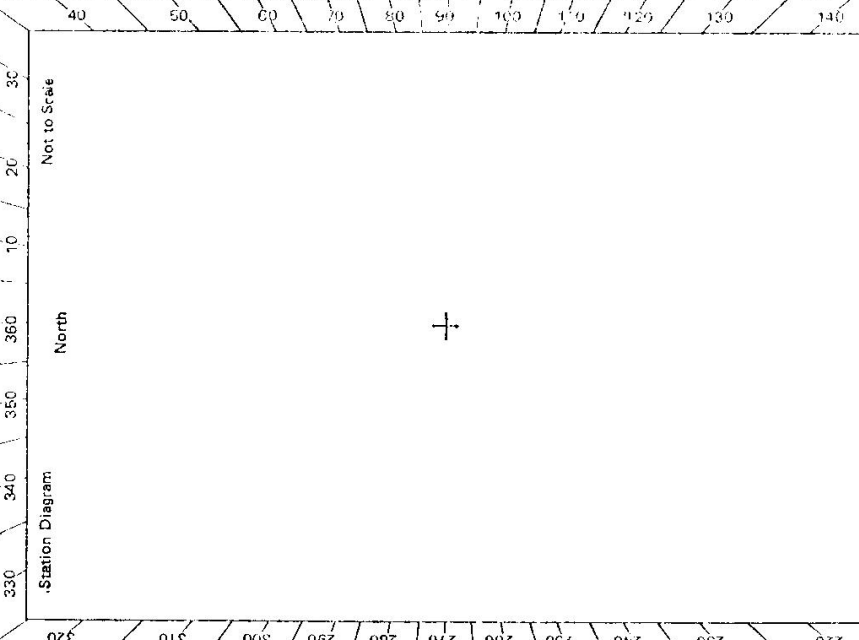

Description:

Note: Cross out word or words which do not apply

1. Cleared by vanes bearing..... **All Clear (including GPS)** ..... from Trig. Mast
2. Mast & Vanes have been painted white & black respectively.  
**Found (placed by Hunter Water Corporation**
3. The ~~station~~ pillar was ~~unpainted~~ **constructed on 20/6/1974**, dimensions now being: **roof top pillar**  
Description of mark..... should be explicit, e.g., S/Steel Pillar Plate, Steel plug, Brass plug, Bolt, G.I. Pipe
- Height of mark.....m. <sup>above</sup> rock/concrete; Mark is.....m. <sup>above</sup> G.L. <sub>below</sub>
- Height of Top Vanes to Top Mark/Pillar plate .....m. Diameter of Vanes (vertical).....m.
- Height of Cairn.....m. Diameter of Cairn.....in. Name Plate found/not found/placed.
- Length of Mast .....m. (approximate if not unpiled)
4. A.....set in conc/rock has been placed/found, bearing.....°M from Mast/Plug/Pillar
5. A.....set in conc/rock has been placed/found, bearing.....°M from Mast/Plug/Pillar
6. A.....set in conc/rock has been placed/found, bearing.....°M from Mast/Plug/Pillar
7. A.....set in conc/rock has been placed/found, bearing.....°M from Mast/Plug/Pillar
8. Action required:.....

**STANDPOINT:**

Mark	Direction	Horiz. Distance	Height Difference	Mark	Direction	Horiz. Distance	Height Difference
			above standpt.				above standpt.
			below				below standpt.
			above standpt.				above standpt.
			below				below standpt.
Prepared by:

Checked: **Noted on U.T.M. Card**

Checked



**LAND INFORMATION CENTRE**

GEODETTIC SURVEY OF N.S.W.


**GEODETTIC STATION RECONNAISSANCE and MAINTENANCE REPORT**

STATION: **COMERFORDS RES** No.: **10950**

MAP SHEET SCALE 1:250 000 **MAITLAND** 1: 25000

INSPECTED BY: **P. O'KANE** DATE: **20/6/94**

AUTHORITY: **SCB Newcastle** FIELD BOOK:

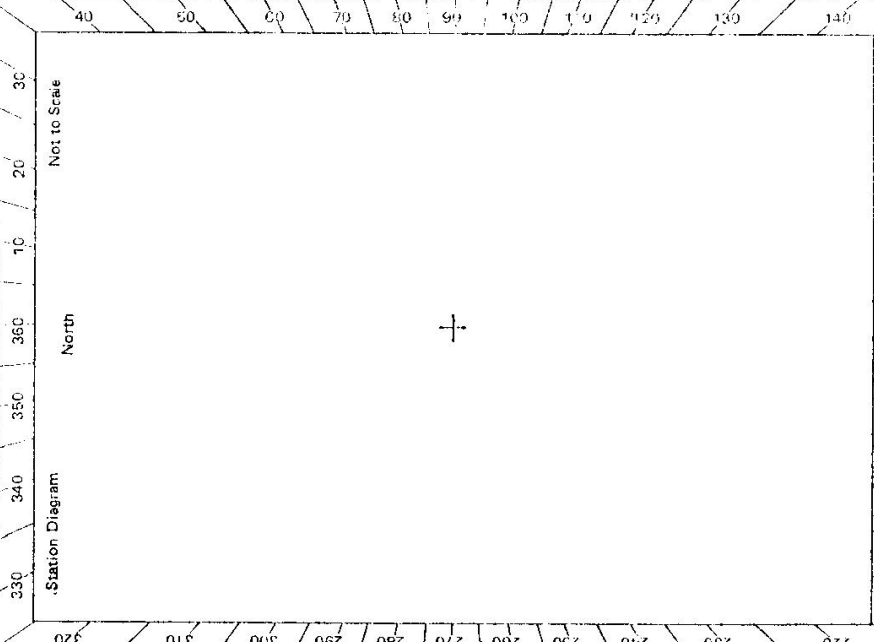

**Description:**

Note: *Cross out word or words which do not apply*


1. Cleared by lanes bearing..... **All Clear (including GPS)** ..... from Trig. Mast
  2. Mast & Vanes have been painted white & black respectively  
**Found (placed by Hunter Water Corporation**
  3. The ~~station~~ pillar was ~~unplaced~~ ~~not unplaced~~ ~~constructed~~ on **20/6** ..... 1975, dimensions now being:  
**Roof top Pillar** should be explicit, e.g., S/Steel Pillar Plate, Steel plug, Brass plug, Bolt, G.I. Pipe
- Height of mark.....m. <sup>above</sup> rock/concrete; Mark is.....m. <sup>above</sup> G.L. <sub>below</sub>
- Height of Top Vanes to Top Mark/Pillar plate .....m. Diameter of Vanes (vertical).....m.
- Height of Cairn.....m. Diameter of Cairn.....m. Name Plate found/not found/placed.
- Length of Mast .....m. (approximate if not unplaced)
4. A.....set in conc/rock has been placed/found, bearing.....°M from Mast/Plug/Pillar
  5. A.....set in conc/rock has been placed/found, bearing.....°M from Mast/Plug/Pillar
  6. A.....set in conc/rock has been placed/found, bearing.....°M from Mast/Plug/Pillar
  7. A.....set in conc/rock has been placed/found, bearing.....°M from Mast/Plug/Pillar

**Action required:**

STANDPOINT:			
Mark	Direction	Horiz. Distance	Height Difference
			above standpt.
			below
			above standpt.
			below
Prepared by: ..... Noted on U.T.M. Card ..... Checked: .....  
S: 2735-1



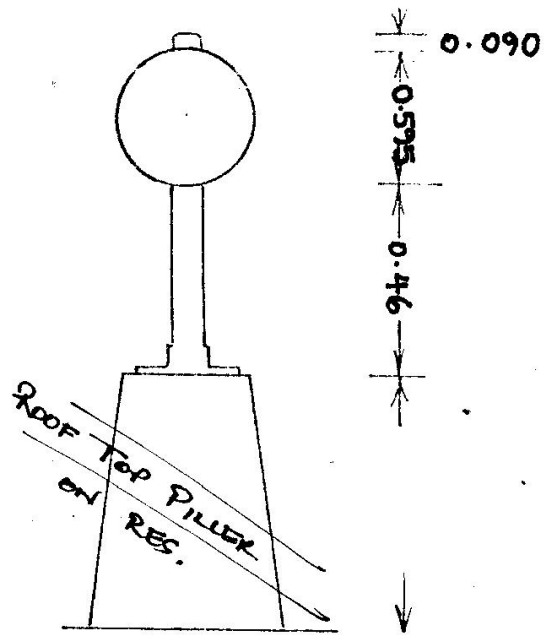

TS (10950) COMERFORDS (RES)

MAST & VANES REPLACED 17/8/94

Received  
18 04 2022  
Survey Control  
Branch