

CENTRAL MAPPING AUTHORITY
Department of Lands

Trigonometrical Survey of N.S.W.

RECONNAISSANCE and MAINTENANCE REPORT

STATION TS 10952 SINGLETON RES

Co: DULRHAM Ph: DARLINGTON
Map Sheet: Singleton 9132-IV-N No:
Inspected by: P. O'Kane Date: 16/11/94
Authority: LIC Newcastle Field Book:

Beacon Diagram Not to Scale


Date: 16/11/94
Record of Station
16/11/94 Pillar Constructed - G. Ford
Trig Fixed

Note: Cross out word or words which do not apply

This Trig. Station has been:-

1. Completely cleared to permit 360° vision to surrounding Trigs. ✓
2. ~~Cleared by fence-bearing~~ from Trig. Mast
3. Trig. Mast & Vanes have been painted white & black respectively.
4. The Trig. was unpiled/not unpiled, dimensions now being:
Description of mark should be explicit, e.g. Steel plug, Brass plug, Bolt, G.I. Pipe
Height of mark m above rock/concrete m above G.L.
Height of Top Vanes to Top Mark m Diameter of Vanes (vertical) m.
Height of Cairn m. Diameter of Cairn m.
Length of Mast m. (approximate if not unpiled)
5. ~~A~~ set in conc/rock has been placed m. bearing °M from Trig. Mast
6. ~~A~~ set in conc/~~soil~~ has been placed m. bearing °M from Trig. Mast
7. ~~A~~ set in conc/soil has been placed m. bearing °M from Trig. Mast
8. ~~A~~ set in conc/rock has been placed m. bearing °M from Trig. Mast

9. Connection to m. bearing °M
10. Connection to m. bearing °M
11. Connection to m. bearing °M
12. Connection to m. bearing °M
13. Diff. Ht. is m. above below
14. Diff. Ht. is m. above below
15. Diff. Ht. is m. above below
16. Diff. Ht. is m. above below

Prepared by: P. O'Kane Checked: Noted on U.T.M. Card

Checked

STATION TS 10952 SINGLETON RESERVOIR

Owners Name... Singleton Council
Current Occupant... Apex Lookout Reserve

Address.....

Address.....

Access

0.0 CNR NEW ENGLAND HWY & HUNTER ST, SINGLETON (COUNTRY COMFORT MOTEL). HEAD NW ALONG HWY - CROSS NEW BRIDGE.

2.65 TURN LEFT INTO MAISON DIEU RD


3.70 TURN LEFT INTO HAMBLEDON HILL RD

4.35 TURN RIGHT INTO LOOKOUT RD

4.60 TS SINGLETON [P]

4.70 RESERVOIR - WI KEY TO BE PICKED UP FROM SINGLETON COUNCIL-ENGINEERING COUNTER.

ACCESS BY ZWD - ANY WEATHER

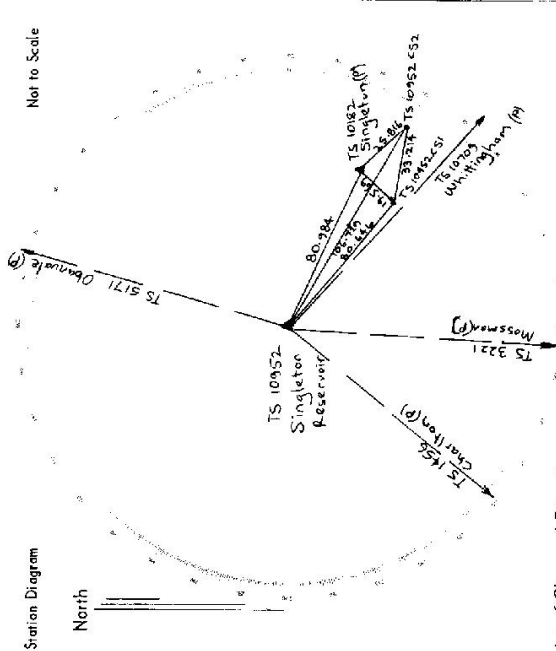

List of Observed Directions:-

Station: TS Singleton Res		Station	Direction
TS Obanvale	14° 11' 48"		
TS Singleton (P)	150° 10' 58"		
TS 10952 CS1	116° 21' 46"		
TS 10952 CS1	125° 05' 20"		
TS Whittingham (P)	130° 53' 21"		
TS Mossman (P)	188° 30' 13"		
TS Charlton (P)	218° 37' 57"		