

7-4-88

Trigonometrical Survey of N.S.W.

CENTRAL MAPPING AUTHORITY  
Department of Lands

RECONNAISSANCE and MAINTENANCE REPORT

STATION (MT) BOSS

1096

This Trig. Station has been:

Note: Cross out word or words which do not apply

1. ~~Completely cleared to provide~~ <sup>timbered blocked</sup> 360° vision to surrounding Trigs.

2. Cleared by lanes bearing ..... from Trig. Mast

3. Trig. Mast & Vanes have been painted white & black respectively.

4. The Trig. was unpiled/not unpiled, dimensions now being:

Description of mark..... should be explicit, e.g. Steel plug, Brass plug, Bolt, G.I. Pipe

Height of mark..... m <sup>above</sup> <sub>below</sub> rock/concrete ..... m <sup>above</sup> <sub>below</sub> G.I.

Height of Top Vanes to Top Mark..... m. Diameter of Vanes (vertical) 0.610 m.

Height of Cairn 0.80 m. Diameter of Cairn 1.60 m.

Length of Mast 3.18 m. (approximate if not unpiled)

5. A..... set in conc/rock has been placed..... m. bearing.....°M from Trig. Mast

6. A..... set in conc/soil has been placed..... m. bearing.....°M from Trig. Mast

7. A..... set in conc/soil has been placed..... m. bearing.....°M from Trig. Mast

8. A..... set in conc/rock has been placed..... m. bearing.....°M from Trig. Mast

9. Connection..... to..... m. bearing.....°M

10. Connection..... to..... m. bearing.....°M

11. Connection..... to..... m. bearing.....°M

12. Connection..... to..... m. bearing.....°M

13. Diff. Ht. .... m. <sup>above</sup> <sub>below</sub>

14. Diff. Ht. .... m. <sup>above</sup> <sub>below</sub>

15. Diff. Ht. .... m. <sup>above</sup> <sub>below</sub>


16. Diff. Ht. .... m. <sup>above</sup> <sub>below</sub>

Prepared by: M.L. Morrison

Noted on U.T.M. Card

Checked

Beacon Diagram Not to Scale

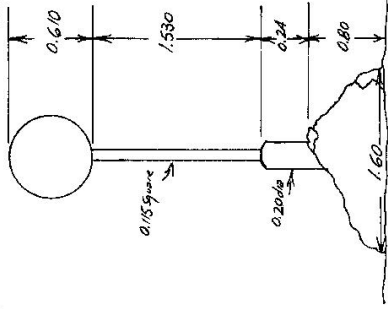

Date	Record of Station
	TRIG. TD IN FAIR CONDITION Mast & Vanes in Good
	ORDER. Cairn in Fair Condition. Keys Missing
	All 4 W. Dots Clearing Roadward to Clear 200 m to 140 m.
	100 m to 200 m. Above some stone and heavily timbered
	Good Vision to SE. Party able to see Monument 1
	To the SW. Clear Area because view to Hill

