

TS10964

STATION TS 10964 Penrith Council: 16PS

Owners Name Penrith City Council

**Current Occupant.....**

Address 601 High St

**Address.....**

Penrith

2012

Phone (02) 4732 7777

none (0471321111  
Civil Centre Operations Supervisor  
(Craig Field)

Take lift to 2nd Floor. ii  
Go out onto northern balcony & follow this around  
to the west.


Go through Plant Room 5  
Use ladder to access roof of plant room & TS

steel observation pillar

**Not to Scale**

### Station Diagram

North

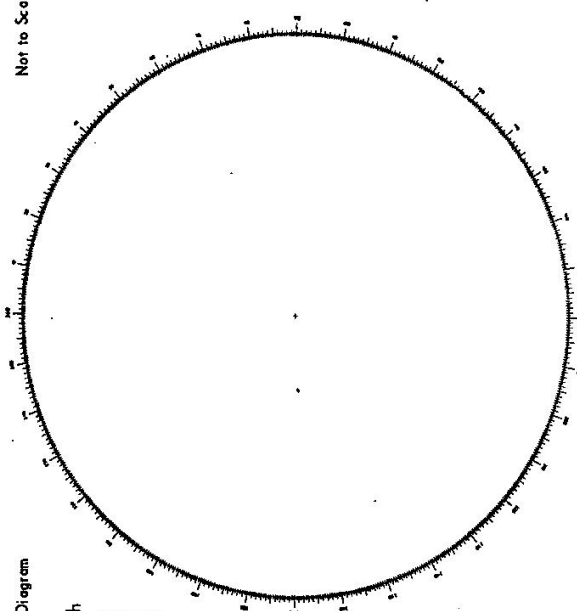

**List of Observed Directions:-**

**Standpoint:**

**Standpoint:**

[illegible]