

7-5-10

Integrat Survey of N.S.W.

Department of Lands

RECONNAISSANCE and MAINTENANCE REPORT 10968 STATION WOLLONGONG COUNCIL

LAND INFORMATION
 Co: CENTRE WOLLONGONG Ph: (042) 277050
 Map Sheet: WOLLONGONG 1:10000 W8285-6 No:
 WOLLONGONG 1:25000 9029-2-5
 Inspected by: M. BOLIE Date: 8-11-96
 Authority L.V.C. Field Book:

Beacon Diagram Not to Scale

Note: Cross out word or words which do not apply

This Trig. Station has been:-

1. Completely cleared to permit 360° vision to surrounding Trigs.
2. Cleared by ~~James-bearing~~ from Trig. Mast
3. Trig. Mast & Vanes have been painted white & black respectively.
4. The Trig. was unpiled/not unpiled, dimensions now being:

Description of mark STEEL ROOFTOP PILLAR should be explicit, e.g. Steel plug, Brass plug, Bolt, Concrete Pillar

Height of mark..... m ^{above} rock/concrete m ^{above} G.L.

Height of Top Vanes to Top Mark/Top pillar plate 1.142 m Diameter of Vanes (vertical) 0.587 m.

Height of Cairn..... m. Diameter of Cairn..... m.


Length of Mast..... m. (approximate if not unpiled)

5. A..... set in conc/rock has been placed/fd m. bearing°M from Trig. Mast/pillar
6. A..... set in conc/soil has been placed/fd m. bearing°M from Trig. Mast/pillar
7. A..... set in conc/soil has been placed/fd m. bearing°M from Trig. Mast/pillar
8. A..... set in conc/rock has been placed/fd m. bearing°M from Trig. Mast/pillar

9. Connection..... to..... m. bearing.....°M
10. Connection..... to..... m. bearing.....°M
11. Connection..... to..... m. bearing.....°M
12. Connection..... to..... m. bearing.....°M

13. Diff. Ht. is. m. ^{above} below
14. Diff. Ht. is. m. ^{above} below
15. Diff. Ht. is. m. ^{above} below
16. Diff. Ht. is. m. ^{above} below

Prepared by: _____ Checked: _____

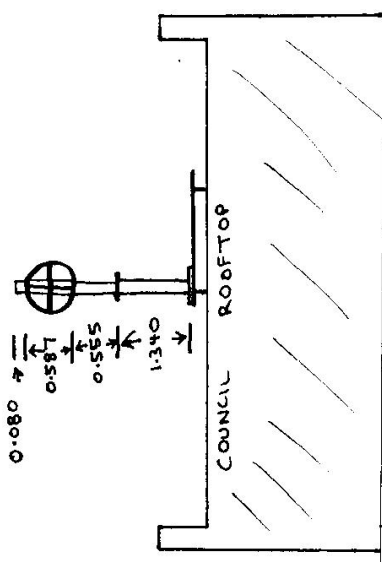

Date	Record of Station
8-11-96	TRIG. CARD FILE OPENED

