

TS HIRWATHA - 10977 REPLACES TS MINNIE WATER RES - TS 10291

Department of Lands

RECONNAISSANCE and MAINTENANCE REPORT

Integrat. Survey of N.S.W.

STATION HIRWATHA TS 10977

This Trig. Station has been:

Note: Cross out word or words which do not apply

1. Completely cleared to permit 360° vision to surrounding Trigs.
2. Cleared by lances bearing from Trig. Mast
3. Trig. Mast & Vanes have been painted white & black respectively.
4. The Trig. was unpiled/not unpiled, dimensions now being:

Description of mark: STEEL Plate on Steel Pillar should be explicit, e.g. Steel plug, Brass plug, Bolt, Concrete Pillar

Height of mark m ^{above} rock/concrete m ^{below} G.L.

Height of Top Vanes to ~~Top Mast~~ Top pillar plate / 445 m Diameter of Vanes (vertical) 0.60 m.

Height of Cairn m. Diameter of Cairn m.

Length of Mast 1.53 m. (approximate if not unpiled)

5. A set in conc/rock has been placed/td m. bearing °M from Trig. Mast/pillar
6. A set in conc/soil has been placed/td m. bearing °M from Trig. Mast/pillar
7. A set in conc/soil has been placed/td m. bearing °M from Trig. Mast/pillar
8. A set in conc/rock has been placed/td m. bearing °M from Trig. Mast/pillar

9. Connection to m. bearing °M

10. Connection to m. bearing °M

11. Connection to m. bearing °M

12. Connection to m. bearing °M

13. Diff. Ht. is m. ^{above} below

14. Diff. Ht. is m. ^{above} below

15. Diff. Ht. is m. ^{above} below

16. Diff. Ht. is m. ^{above} below


Prepared by: _____

Checked: _____

STATION HIRWATHA TS 10977	
Co: CLARENCE	Ph: No. 9538 11-N
Map Sheet: BARE POINT	Date:
Inspected by: PETER McGRATH	Field Book: ←
Authority: L.I.C.	
Beacon Diagram	
Date	Record of Station
JAN 96	NEW RESERVOIR CONSTRUCTED & TRIG ERECTED ON OLD SITE OF MINNIE WATER RES.

STATION AIRWORTHY TS 10977

Not to Scale

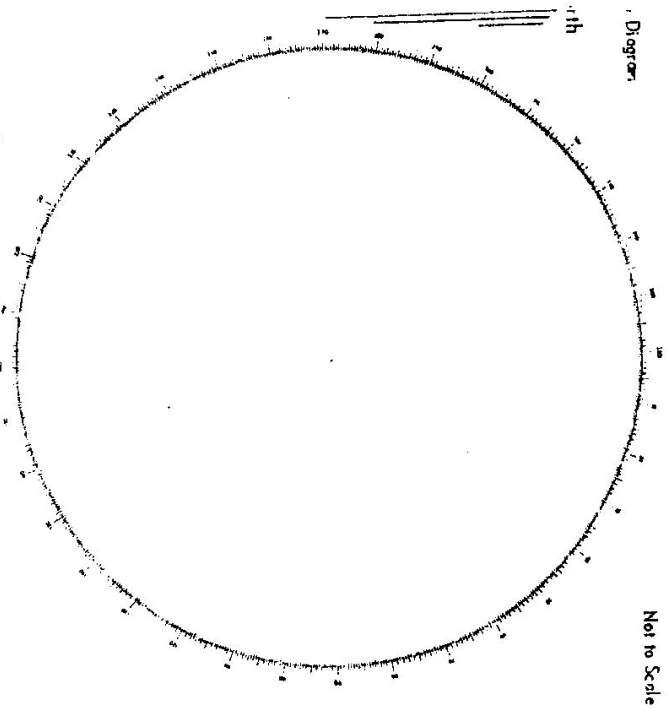

of Observed Directions:-

Standpoint:		Standpoint:	
Station	Direction	Station	Direction

Owners Name: LINDARRA SHIRE

Current Occupant:

Address: GOLD STREET ST.

Address:

LINDARRA

Access

AT MINE WATER: Turn right through Caravan Park Travel about 400m past Office to top of hill. Key at Caravan Park Office.

To ordinals & Height. FIXED BY GPS. Nov 97 Adjustment No. 96137.