

LAND INFORMATION CENTRE

GEODETTIC SURVEY OF A.S.W.

GEODETTIC STATION RECONNAISSANCE and MAINTENANCE REPORT


STATION: **TEMORA RESERVOIR PILLAR** No.: **10979**

MAP SHEET
SCALE 1:250 000

INSPECTED BY: **D.J. KAIN** DATE: **18-9-96**

AUTHORITY: **L.I.C.** FIELD BOOK: **---**

- Description:
- Cleared by lances bearing **360° Vision from Station** from Trig. Mast
 - Mast & Vanes have been painted white & black respectively. ✓
 - The ~~station~~ pillar was ~~replaced~~ constructed on **17 September 1996**, dimensions now being: **STEEL Pillar Plate**
Description of mark **On Steel Pillar** should be explicit, e.g., S/Steel Pillar Plate, Steel plug, Brass plug, Bolt, G.I. Pipe
Height of mark **1.790** m. ^{above} ~~below~~ **Reservoir Platform** Mark ism. ^{above} ~~below~~ G.L.
Height of Top Vanes to Top ~~mark~~ Pillar plate **0.675** m. Diameter of Vanes (vertical) **0.385** m.
Height of Cairnm. Diameter of Cairnm. Name Plate ~~found~~ /not found/ placed.
Length of Mast **0.290** m. (~~approximate if not supplied~~)
 - A **NIL PLACED** set in conc/rock has been placed/found, bearing° M from Mast/Plug/Pillar
 - A set in conc/rock has been placed/found, bearing° M from Mast/Plug/Pillar
 - A set in conc/rock has been placed/found, bearing° M from Mast/Plug/Pillar
 - A set in conc/rock has been placed/found, bearing° M from Mast/Plug/Pillar
 - Action required:

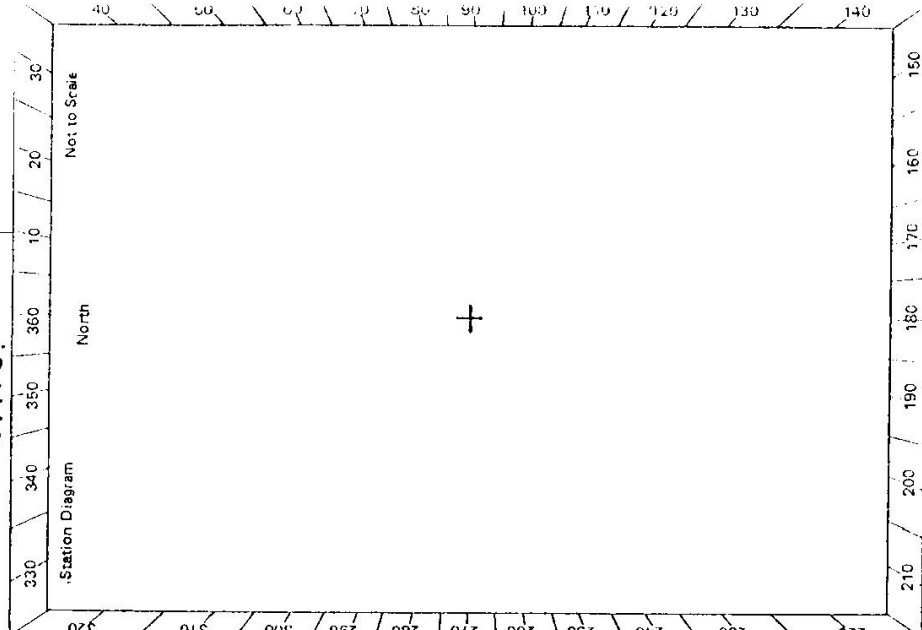

STANDPOINT:

Mark	Direction	Horiz. Distance	Height Difference	Mark	Direction	Horiz. Distance	Height Difference
			above standpt.				above standpt.
			below				below
			above standpt.				above standpt.
			below				below
Prepared by: **D. Kain** Checked: **Alba 28/5/1997** Noted on U.T.M. Card

Checked

STATION TEMORA RESERVOIR PILLAR 1510979

Owner's Name: SOUTH WEST TABLELANDS
 Address: WATER SUPPLY
 c/ Paul Ballard (Mgr) COMMUNOAM
 Phone: (069) 423760

Current Occupant: DAVE PEARCY
 Address: S.W.I.W.S. - TEMORA BUMPING STATION
 Phone: 069 772247

ACCESS


Access Report of: /19 was found suitable/unavailable

Located on tallest steel reservoir Loftus St. Temora.
 Bolted to the top landing of steel spiral stairs and braced to the railing with stainless steel clamps.

* THIS TRIG IS NOT TO BE OCCUPIED BY THE PUBLIC *

- This trig was placed to be observed top - not from
- Under OH&S & Public Works safety rules for water reservoirs this trig cannot be used unless very strict safety provisions are followed and permission is granted prior to occupation.

2733-2 D. West, Government Printer

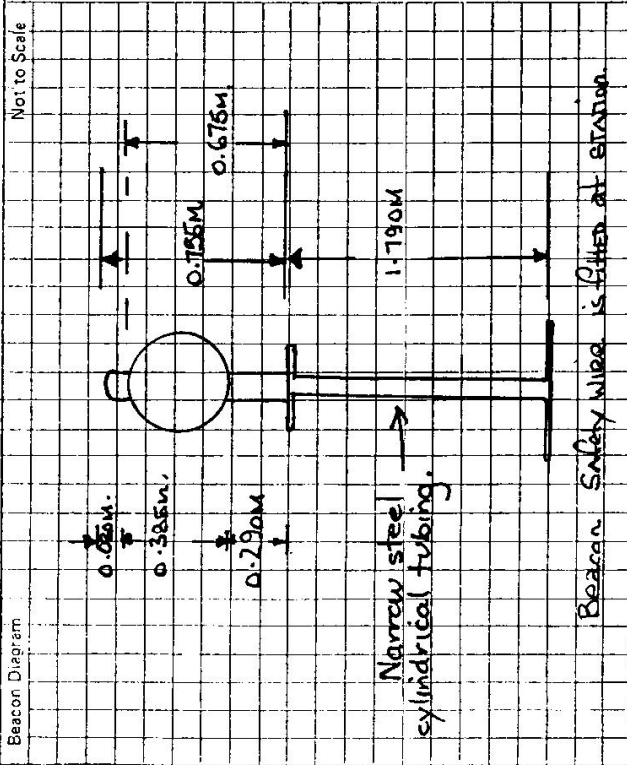

This section to be completed by officer constructing pillar.

Original station mark found/not found: N/A - NEW MARK
 Description of mark: Smaller than usual rooftop type pillar
 Original beacon found/not found: N/A
 Description of beacon: Conventional M&V though shorter
 Height Top of Vanes to Top Mark: 0.675 m.
 Height of mark: 1.79 m. above G.L. steel
 Diameter of Vanes 0.755 m. below
 Height of Cairn: N/A m.
 Original Beacon has/has not been destroyed by m&v: N/A

Date	Record of Station