

7-4-98

CENTRAL MAPPING AUTHORITY
Department of Lands
Trigonometrical Survey of N.S.W.

RECONNAISSANCE and MAINTENANCE REPORT

STATION **BOTOBOLAR T.S. 1098**


Co: **PHILLIP** Ph: **BUTCHLAR**

Map Sheet: **MUDGE (NORTH)** No: **8832**

Inspected by: **P. JACKSON** Date: **2nd May 1975**

Authority: **GEODETIC SURVEY DIV** Field Book: **1426**

Beacon Diagram Not to Scale

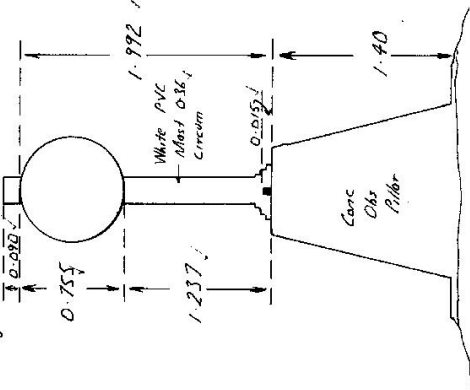

This Trig. Station has been:-
Note: Cross out word or words which do not apply

1. Completely cleared to permit 360° vision to surrounding Trigs.
2. Cleared by lances bearing..... from Trig. Mast
3. Trig. Mast & Vanes have been painted white & black respectively.
4. ~~The Trig. was unspiled/not unspiled, dimensions now being:~~
Description of mark: ~~Conc Obs~~ *Pillar* should be explicit, e.g. Steel plug, Brass plug, Bolt, G.I. Pipe
Height of mark: ~~0.615~~ *0.615* m ^{above} ~~below~~ *Pillar Plate* ~~below~~ *G.L.*
Height of Top Vanes to Top Mark: ~~1.572~~ *1.572* m. Diameter of Vanes (vertical) ~~0.755~~ *0.755* m.
Height of Cairn..... m. Diameter of Cairn..... m.
Length of Mast ~~2.082~~ *2.082* m. (approximate if not unspiled)
5. ~~A Trig. Pillar~~ *Pillar* set in conc/rock has been placed ~~3.665~~ *3.665* m. bearing ~~114° S~~ *114° S* °M from Trig. Mast
6. ~~A G.I. Pipe~~ *Pillar* set in conc/rock has been placed ~~3.570~~ *3.570* m. bearing ~~52° S~~ *52° S* °M from Trig. Mast
7. ~~A S.S.M.~~ *Pillar* set in conc/rock has been placed ~~1.915~~ *1.915* m. bearing ~~98° S~~ *98° S* °M from Trig. Mast
8. ~~A~~ *Pillar* set in conc/rock has been placed..... m. bearing..... °M from Trig. Mast
9. Connection.....to..... m. bearing.....°M
10. Connection.....to..... m. bearing.....°M
11. Connection.....to..... m. bearing.....°M
12. Connection.....to..... m. bearing.....°M
13. Diff. Ht. ~~TRIG. 44.6~~ *TRIG. 44.6* is ~~1.430~~ *1.430* m. ~~above~~ *below* ~~Pillar Plate~~ *Pillar Plate*
14. Diff. Ht. ~~S.S.M.~~ *S.S.M.* is ~~1.550~~ *1.550* m. ~~above~~ *below* ~~Pillar Plate~~ *Pillar Plate*
15. Diff. Ht. ~~G.I.P.~~ *G.I.P.* is ~~1.505~~ *1.505* m. ~~above~~ *below* ~~Pillar Plate~~ *Pillar Plate*
16. Diff. Ht. ~~is~~ *is*..... m. ~~above~~ *below*.....

As above


Date	Record of Station
2-5-75	Connections & Angle Obs
8-2-77	Trig. visited & Rt in good condition.
24-10-77	Cleared to permit S.S. MOUNTAIN S.S.P. & MOUNTAIN S.S.P.

Prepared by: *P. Jackson* Checked: *P. Jackson* 6-11-75 Noted on U.T.M. Card *10 3 76*

STATION BOTADOLAR T.S. 1098

Owners Name.....
 Current Occupant.....
 Address.....
 Address.....
 Access.....
 Access.....

Not to Scale

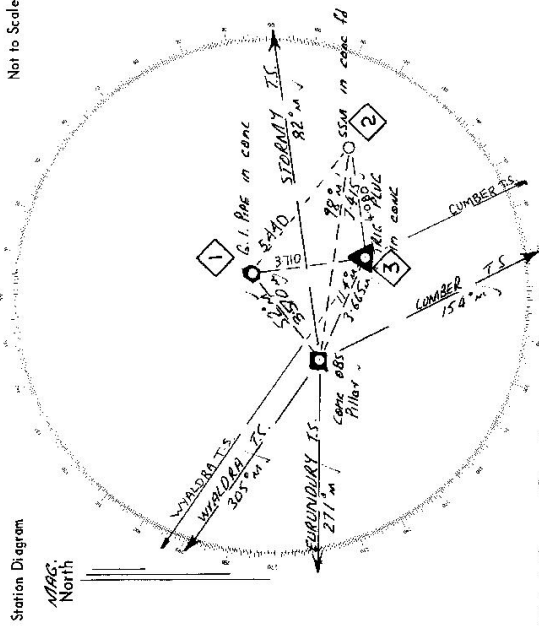

List of Observed Directions:-

Standpoint: Conc Pillar		Standpoint: Brass Trig Plug in conc.	
Station	Direction	Station	Direction
WALADRA T.S.	359° 59' 60"	WALADRA T.S.	359° 59' 60"
G.I. Pipe in conc.	48° 24'	G.I. Pipe in conc.	48° 24'
S.S.M. in conc.	157° 01'	S.S.M. in conc.	157° 01'
CUMBER (Pillar) T.S.	208° 54' 00"	CUMBER (Pillar) T.S.	208° 54' 00"
PILLAR Sighting	350° 34'	PILLAR Sighting	350° 34'
CONC. PILLAR			
Station	Direction	Station	Direction
WALADRA T.S.	359° 59' 60"		
G.I. Pipe in conc.	106° 55'		
S.S.M. in conc.	157° 52'		
Brass Trig Plug in	170° 34'		
CUMBER (Pillar) T.S.	208° 55' 42"		


STATION BOTOBOL 2 (PILLAR) TS 1098

Owners Name:
 Current Occupant:
 Address:
 Address:

Access 6-12-75
 To 1/2 mile CONVENTIONAL VEHICLE


0-00 CROSS TOILET HILL END HILL, TAKE RIGHT TO INDUSTRIAL ALONG LINDSAY RD
 10-0 TAKE MUSWELLBROOK RD TO RIGHT.
 15-7 TAKE DIRT ROAD ON RIGHT SIGNPOSTED "BOTOBOL"
 FOLLOW THIS ROAD. THREE ROADS COME IN ON RIGHT AT
 19-7 kms, 28-9 kms & 29-9 kms.
 32-5 GRID.
 32-6 TAKE TRAIL TO LEFT SIGNPOSTED "TRIG HILL"
 33-75 GRID.
 34-10 GAP IN FENCE ON RIGHT. DRIVE ACROSS PARKLAND TREES
 34-15 TS.

Not to Scale

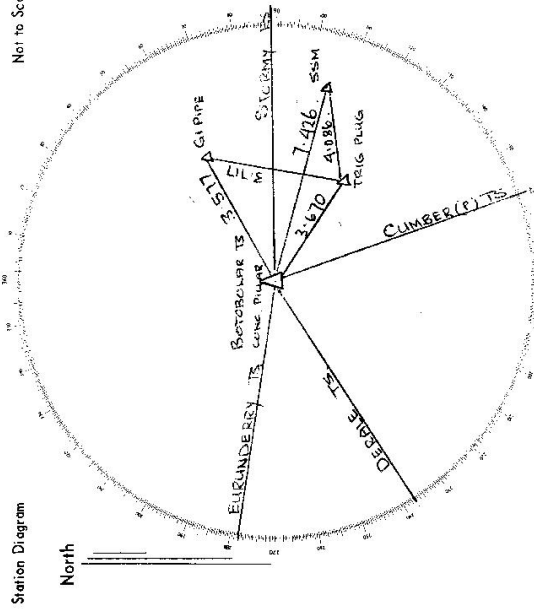

List of Observed Directions:-

Standpoint: PILLAK		Standpoint:	
Station	Direction	Station	Direction
STORMY TS	0° 00' 00"		
CUMBER TS	71° 52' 44"		Misidentification #
DEALE TS	138° 56' 49"		Misidentification #
EUKUNDERY TS	189° 00' 51"		
STORMY TS	0° 00' 00"		
STORMY TS	15° 51' 46"		
DIRT TRIG HILL	33° 32' 32"		
EUKUNDERY TS	189° 00' 48"		
GI PIPE	331° 51' 38"		

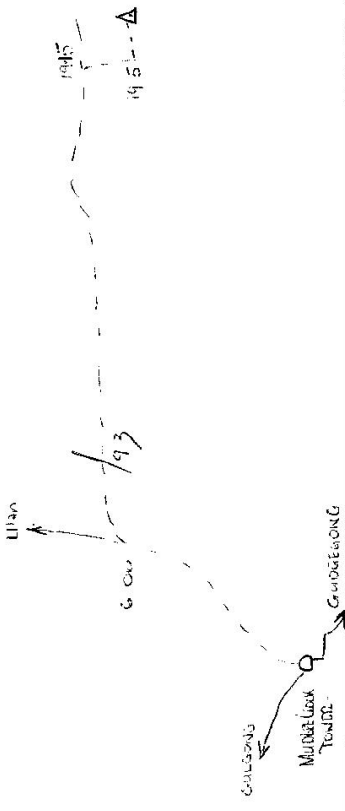

GEODETTIC SURVEY OF N.S.W.

CENTRAL MAPPING AUTHORITY

GEODETTIC STATION RECONNAISSANCE and MAINTENANCE REPORT

- Description: *Note: Cross out word or words which do not apply*
- Cleared by lanes bearing *140°M* to *123°M* from Trig. Mast
 - Mast & Vanes have been painted white & black respectively.
 - The ~~station~~ pillar was unpiled/~~not~~ constructed on *20x4x6x15x* 19' 8" dimensions now being *5x6x6x6* should be explicit, e.g., S/Steel Pillar Plate, Steel plug, Brass plug, Bolt, G.I. Pipe
- Description of mark: *1400* m. above ~~rock~~ concrete; Mark is *1520* m. above G.L.
- Height of Top Vanes to Top ~~mark~~/Pillar plate *1355* m. Diameter of Vanes (vertical) *0.750* m.
- Height of Cairn.....m. Diameter of Cairn.....m. Name Plate found/~~not~~ placed.
- Length of Mast.....m. (approximate if not unpiled)
- Brass Trig. Peg* set in conc/~~rock~~ has been placed/found, bearing *110* °M from ~~Mast/Plug~~/Pillar
 - Brass Pipe* set in conc/~~rock~~ has been placed/found, bearing *45* °M from ~~Mast/Plug~~/Pillar
 - SS Peg* set in conc/~~rock~~ has been placed/found, bearing *90* °M from ~~Mast/Plug~~/Pillar
 - A* set in conc/~~rock~~ has been placed/found, bearing.....°M from Mast/~~Plug~~/Pillar
- Action required:.....

STANDPOINT:

Mark	Direction	Horiz. Distance	Height Difference	Mark	Direction	Horiz. Distance	Height Difference
			above standpt.				above standpt.
			below				below
			above standpt.				above standpt.
			below				below
Prepared by: *P. Harris 20x Aug 05x* Checked: *Noted on U.T.M. Card*

S:2723-1

STATION: *20x060212 G1 (A)* No.: *1098*

MAP SHEET SCALE 1:250 000 *Dudsko*

INSPECTED BY: *P. Harris* DATE: *20.8.81*

AUTHORITY: *C.M.A* FIELD BOOK: *1835*

STATION **8070 DOLLAR GS (P)** 1098


Owner's Name: **MR R. ARTHUR**
 Address: **19 CARALINA CRESSANS**
HIDGE
 Phone: **73 3 235**

Current Occupant:
 Address:
 Phone:

ACCESS

Access Report of 20/8/1981 was found suitable/unsuitable.
 KM **LEPPULE**
 0.00 **BOX OFFICE HIDGE KEPA TOWARDS CENTRE OF TOWN**
 0.27 **TURN LEFT ON G. CASSILL'S ROAD**
 0.72 **TURN RIGHT SIGN MOLLAR 40 BYLONS 61**
 1.09 **END SEALED ROAD**
 1.72 **PAS ROAD ON RIGHT**
 2.47 **PAS ROAD ON LEFT**
 2.83 **PAS ROAD ON RIGHT**
 3.05 **GRID**
 30.74 **TURN LEFT SIGN "TRIG HILL"**
 32.10 **GRID 3 THEN TURN SHARP RIGHT**
 32.12 **IRON GATE - MAKE OWN WAY UP RIDGE TO TRIG**
 32.53 **8070 DOLLAR GS (P)**

Sr: 2733 - 2 D. West, Government Printer

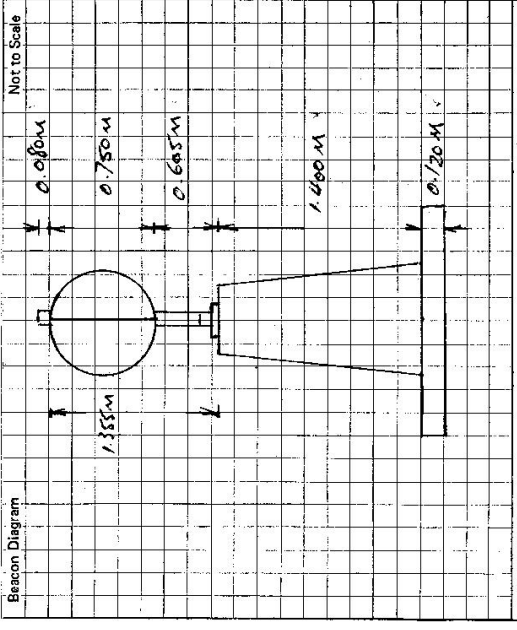

This section to be completed by officer constructing pillar.

Original station mark found/not found.

Description of mark:

Original beacon found/not found.

Description of beacon:

Height Top of Vanes to Top Mark:m.

Height of mark:m. above G.L.
m. below

Diameter of Vanes:m. Height of Cairn:m.

Original Beacon has/has not been destroyed by me.

Date

Record of Station