	15. Diff. Ht. is
	Diff. Ht.
	13. Diff. Htisis
14/1/19 PANCH HOLE IN STEEL UNDER TOWER	12. Connectionto:to:
Date Record of Station	11. Connectiontoto
	10. Connectiontoto
0	9. Connection TS 168 to TS 10986 7.774 m. bearing 233 M
	8. A
	7. A
	6. Aset in conc/soil has been placed fdm. bearing
	5. Aset in conc/rock has been placed/fdm. bearingM from Trig. Mast/pillar
	Length of Mast
	Height of Cairnm. Diameter of Cairnm.
	Height of Top Vanes to Top Mark/Top pillar platem Diameter of Vanes (vertical)m.
	Height of mark m above sock/concrete
	Description of mark
	4. The Trig. was unpiled/not unpiled, dimensions now being:
Beacon Ulagram Nor to Scale	3. Trig. Mast & Vanes have been painted white & black respectively.
D, NEWCASTLE Field BO	2. Cleared by lones bearing
	1. Completely cleared to permit 360° vision to surrounding Trigs.
Map Sheet: BROKEN BACK 1:25000 No: 1	
CO: NORTHUMBERLAND Ph: OVINCHAM	This Tria. Station has been:- Note: Cross out word or words which do not apply
STATION TS 10986 SHOKEN BACK EAST TWR	Department of Lands RECONNAISSANCE and MAINTENANCE REPORT
26142	


^тл. н. . . .

•

2

ţ,

Antonia late an anna an

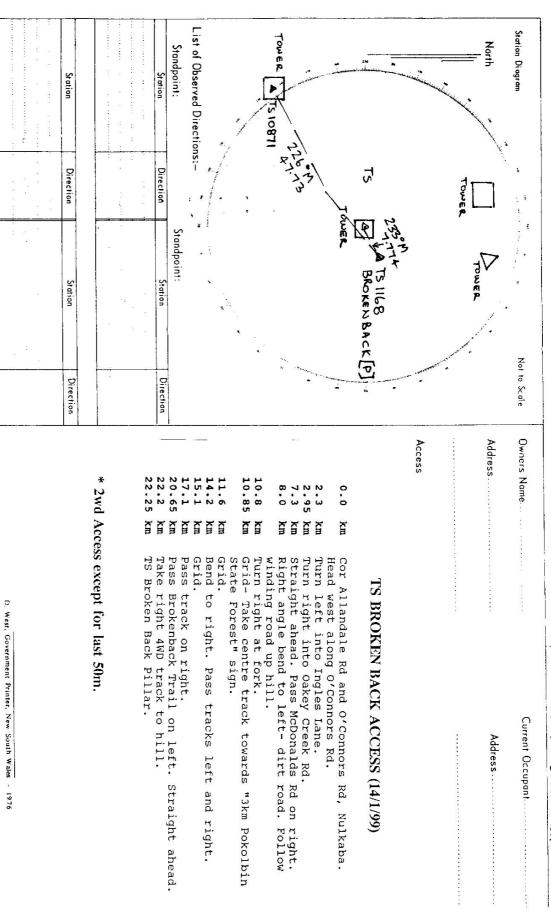

D