

CENTRAL MAPPING AUTHORITY

GEODETIC SURVEY OF N.S.W.

GEODETIC STATION RECONNAISSANCE and MAINTENANCE REPORT


STATION: BOURKE NORTH BASE No.: 1104

MAP SHEET SCALE 1:250 000 MT. OXLEY 1:100 000

INSPECTED BY: Integration S.D. DATE: Sept., 1981

AUTHORITY: C.I.O. FIELD BOOK:

- 1. Cleared by Janes bearing..... Note: Cross out word or words which do not apply
- 2. Mast & Vanes have been painted white & black respectively.
- 3. The station/pillar was unpiled/not unpiled/constructed on.....19....., dimensions now being:
Description of mark..... should be explicit, e.g., S/Steel Pillar Plate, Steel plug, Brass plug, Bolt, G.I. Pipe
Height of mark.....m. ^{above}/_{below} rock/concrete; Mark is.....m. ^{above}/_{below} G.L.
- Height of Top Vanes to Top Mark/Pillar plate.....m. Diameter of Vanes (vertical).....m.
- Height of Cairn.....m. Diameter of Cairn.....m. Name Plate found/not found/placed.
- Length of Mast.....m. (approximate if not unpiled)
- 4. A.....set in conc/rock has been placed/found, bearing.....°M from Mast/Plug/Pillar
- 5. A.....set in conc/rock has been placed/found, bearing.....°M from Mast/Plug/Pillar
- 6. A.....set in conc/rock has been placed/found, bearing.....°M from Mast/Plug/Pillar
- 7. A.....set in conc/rock has been placed/found, bearing.....°M from Mast/Plug/Pillar
- 8. Action required:.....

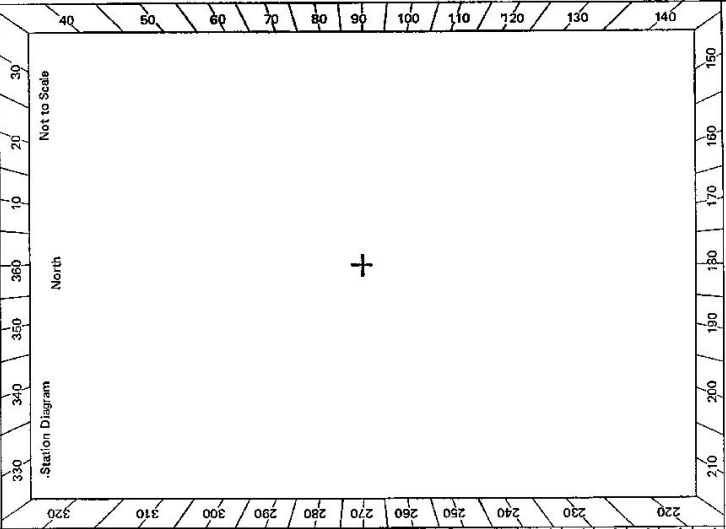

STANDPOINT:				STANDPOINT:			
Mark	Direction	Horiz. Distance	Height Difference	Mark	Direction	Horiz. Distance	Height Difference
			above standpt				above standpt
			below				below
			above standpt				above standpt
			below				below
Prepared by: *[Signature]* 30.10.81

Checked: *[Signature]*

Noted on U.T.M. Card

SI 2733-2 D. West, Government Printer

Not to Scale

Beacon Diagram



STATION

110A

Owner's Name:
 Address:
 Phone:
 Current Occupant:
 Address:
 Phone:

Phone: (697)
 ACCESS
 Access Report of 9/1981 was found suitable/unsuitable.

This section to be completed by officer constructing pillar.

Original station mark found/not found.
 Description of mark:
 Original beacon found/not found.
 Description of beacon:
 Height Top of Vanes to Top Markm.
 Height of markm. above G.L.
 below rock/concm. below
 Diameter of Vanesm. Height of Calmm.
 Original Beacon has/has not been destroyed by me.

Date	Record of Station

LAND INFORMATION CENTRE

GEODETIC SURVEY OF N.S.W.

GEODETIC STATION RECONNAISSANCE and MAINTENANCE REPORT

STATION: *Bourke North Base* No.: *1107*

MAP SHEET
SCALE 1:250 000

INSPECTED BY: *M Morrison*

DATE: *27/10/94*

AUTHORITY: *LIC*

FIELD BOOK: *---*

- Description:
1. Cleared by lanes bearing.....
 2. Mast & Vanes have been painted white & black respectively.
 3. The station/pillar was unpiled/not unpiled/constructed on.....19....., dimensions now being:
Description of mark.....should be explicit, e.g., S/Steel Pillar Plate, Steel plug, Brass plug, Bolt, G.I. Pipe
Height of mark.....m. above rock/concrete; Mark is.....m. above G.L.,
Height of Top Vanes to Top Mark/Pillar plate.....m. Diameter of Vanes (vertical).....m.
Height of Cairn.....m. Diameter of Cairn.....m. Name Plate found/not found/placed.
Length of Mast.....m. (approximate if not unpiled)
 4. A.....set in conc/rock has been placed/found, bearing.....°M from Mast/Plug/Pillar
 5. A.....set in conc/rock has been placed/found, bearing.....°M from Mast/Plug/Pillar
 6. A.....set in conc/rock has been placed/found, bearing.....°N from Mast/Plug/Pillar
 7. A.....set in conc/rock has been placed/found, bearing.....°M from Mast/Plug/Pillar
 8. Action required:.....

STANDPOINT:				STANDPOINT:			
Mark	Direction	Horiz. Distance	Height Difference	Mark	Direction	Horiz. Distance	Height Difference
			above standpt.				above standpt.
			below.				below.
			above standpt.				above standpt.
			below.				below.
Prepared by: *[Signature]* 25/10/94 Checked: *[Signature]*

