

CENTRAL MAPPING AUTHORITY

GEODETIC SURVEY OF N.S.W.


GEODETIC STATION RECONNAISSANCE and MAINTENANCE REPORT

STATION: BOXER No.: 1116

MAP SHEET SCALE 1:250 000 Goulburn

INSPECTED BY: A. Sivertson DATE: 11-10-78

AUTHORITY: CMA FIELD BOOK: 1642

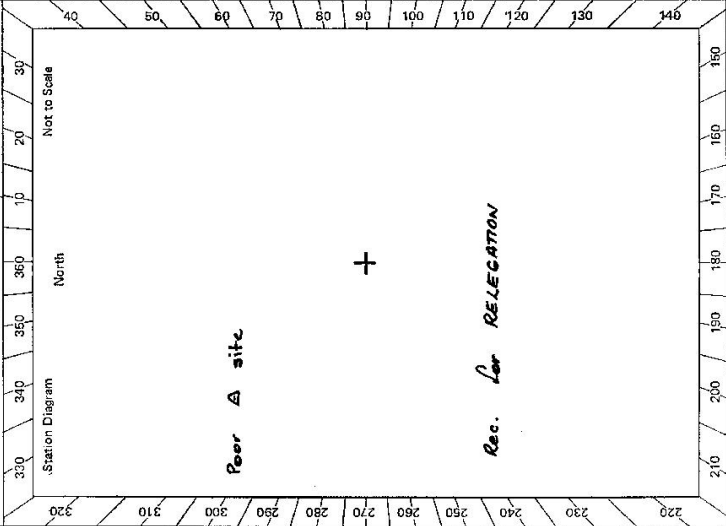

- Description:
- Cleared by lanes bearing  $05^{\circ} 07' 11''$  -  $27^{\circ} 11' 57''$  ~~62-95~~ ~~rest is blocked~~ from Trig. Mast by shade trees
  - Mast & Vanes have been painted white & black respectively. Cairn, Mast & Vanes in poor condition
  - The station ~~marker~~ was unplaced/not unplaced/~~constructed on~~  $19$  m, dimensions now being: Description of mark. ~~should be explicit, e.g., S/Steel Pillar Plate, Steel plug, Brass plug, Bolt, G.I. Pipe~~
  - Height of mark.  $3.4$  m. ~~above~~ rock/concrete; Mark is  $2.2$  m. ~~above~~ G.I. Cairn
  - Height of Top Vanes to Top ~~Marker/Pillar plate~~  $2.2$  m. Diameter of Vanes (vertical)  $0.74$  m.
  - Height of Cairn.  $1.2$  m. Diameter of Cairn.  $2$  m. Name Plate ~~found/not found/placed~~.
  - Length of Mast.  $3.4$  m. (approximate if not unplaced)  $4.12$  m
  - A.  $6$  m. ~~set in conc/rock has been placed/found~~ bearing  $33.2^{\circ}$  M from Mast/~~Height~~ ~~to~~
  - A.  $5$  m. ~~set in conc/rock has been placed/found~~ bearing  $^{\circ}$  M from Mast/Plug/Pillar
  - A.  $6$  m. ~~set in conc/rock has been placed/found~~ bearing  $^{\circ}$  M from Mast/Plug/Pillar
  - A.  $7$  m. ~~set in conc/rock has been placed/found~~ bearing  $^{\circ}$  M from Mast/Plug/Pillar
  - Action required: ~~BUNGONIA~~ 1:25,000

STANDPOINT:			
Mark	Direction	Horiz. Distance	Height Difference
			above standpt.
			below standpt.
			above standpt.
			below standpt.
Prepared by: *[Signature]* Checked: *[Signature]* Noted on U.T.M. Card

STATION **BOXER** 1116

Owner's Name: .....  
 Address: .....  
 Phone: .....  
 Current Occupant: .....  
 Address: .....  
 Phone: .....

**ACCESS**

Access Report of 11/10/1978, was found suitable/unsuitable.

**GOULBURN**

- 0.0 At intersection of BRADWOOD & BUNGONIA roads just over rly. bridge near petrol depots & racecourse.
- Take BUNGONIA road.
- 1.45 Take BOXER RD to L
- 3.1 End bitumen
- 5.3 Pass road to Home Hwy on L
- 6.1 Pass road to Bungonia Road on R
- 6.3 Through iron gate on R at end of pine trees. Make own way to A of 6.8.

Beacon Diagram	Not to Scale

This section to be completed by officer constructing pillar.  
 Original station mark found/not found.  
 Description of mark: .....  
 Original beacon found/not found.  
 Description of beacon: .....  
 Height Top of Vanes to Top Mark .....m.  
 Height of mark .....m. above G.L. below rock/conc .....m.  
 Diameter of Vanes .....m. Height of Cairn .....m.  
 Original Beacon has/has not been destroyed by me.

Date	Record of Station

St.2735-2 D. West. Government Printer