

CENTRAL MAPPING AUTHORITY

GEODETIC SURVEY OF N.S.W.

GEODETIC STATION RECONNAISSANCE and MAINTENANCE REPORT

Description:

1. Cleared by lanes bearing 3.9° 192° 2.20° 2.43° 307° 337° from Trig. Mast
Note: Cross out word or words which do not apply
2. Mast & Vanes have been painted white & black respectively.
3. The station/pillar was ~~unfilled~~/not unpiled/constructed on 19 dimensions now being:

Description of mark should be explicit, e.g., S/Steel Pillar Plate, Steel plug, Brass plug, Bolt, G.I. Pipe

Height of mark m. ^{above} _{below} rock/concrete; Mark is m. ^{above} _{below} G.L.

Height of Top Vanes to Top Mark/Pillar plate m. Diameter of Vanes (vertical) m.

Height of Cairn m. Diameter of Cairn m. Name Plate found/not found/placed.

Length of Mast m. (approximate if not unpiled)

4. A set in conc/rock has been placed/found, bearing M from Mast/Plug/Pillar
5. A set in conc/rock has been placed/found, bearing M from Mast/Plug/Pillar
6. A set in conc/rock has been placed/found, bearing M from Mast/Plug/Pillar
7. A set in conc/rock has been placed/found, bearing M from Mast/Plug/Pillar
8. Action required:

STANDPOINT:

Mark	Direction	Horiz. Distance	Height Difference	Mark	Direction	Horiz. Distance	Height Difference
			above standpt.				above standpt.
			below				below
			above standpt.				above standpt.
			below				below
Prepared by: *W. Miller* 201178

Checked: *W. Miller*

Noted on U.T.M. Card

SF 2733-1

Checked

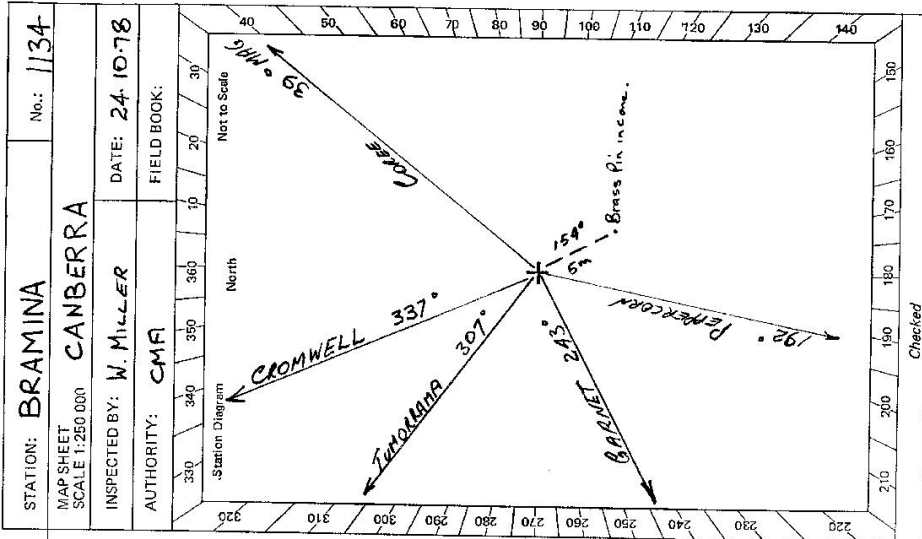

STATION: BRAMINA No.: 1134

MAP SHEET SCALE 1:250 000 CANBERRA


INSPECTED BY: W. MILLER DATE: 24.10.78

AUTHORITY: CMA FIELD BOOK:

STATION **BRAMINA** 1134


Owner's Name:
 Address:
 Phone:

Current Occupant:
 Address:
 Phone:

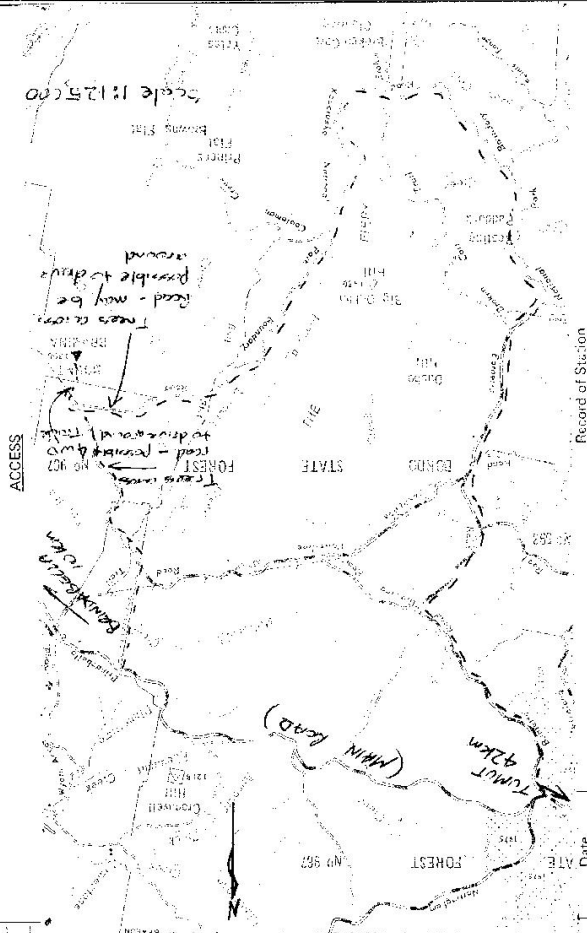

Date:
 Record of Station: 24.10.78 Digital station - extensive clearing has been done.

Sr. 2739-2 D. West. Government Printer

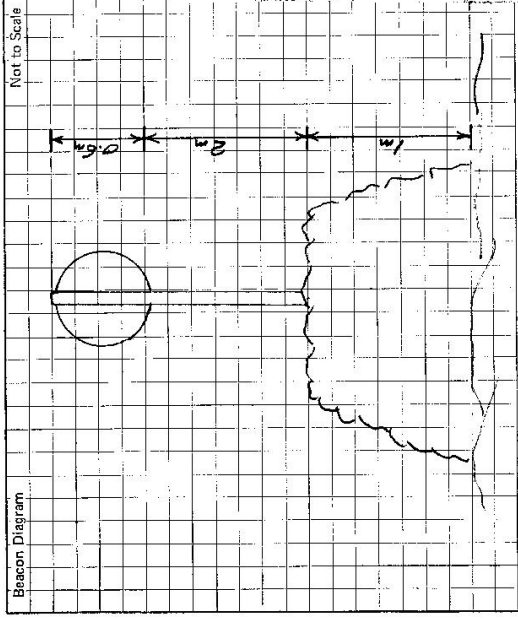

This section to be completed by officer constructing pillar.

Original station mark found/not found.

Description of mark:

Original beacon found/not found.

Description of beacon:

Height Top of Vanes to Top Mark.....m.

Height of mark.....m. above G.L. below

Diameter of Vanes.....m. Height of Cairn.....m.

Original Beacon has/not been destroyed by me.