

CENTRAL MAPPING AUTHORITY

GEODETIC SURVEY OF N.S.W.
 GEODETIC STATION RECONNAISSANCE and MAINTENANCE REPORT

STATION: **BRANSBY** No.: **1137**
 MAP SHEET SCALE 1:250 000 **CANBERRA**
 INSPECTED BY: **W. MILLER** DATE: **12.1.19**
 AUTHORITY: **CMF** FIELD BOOK:


Description:
 Note: Cross out word or words which do not apply

- Cleared by lanes bearing..... from Trig. Mast
- Mast & Vanes have been painted white & black respectively.
- The station/pillar was unpiled/not unpiled/constructed on..... 19....., dimensions now being:
 Description of mark.....should be explicit, e.g., S/Steel Pillar Plate, Steel plug, Brass plug, Bolt, G.I. Pipe
 Height of mark.....m. ^{above} _{below} rock/concrete; Mark is.....m. ^{above} _{below} G.L.
 Height of Top Vanes to Top Mark/Pillar plate.....m. Diameter of Vanes (vertical).....m.
 Height of Cairn.....m. Diameter of Cairn.....m. Name Plate found/not found/placed.
 Length of Mast.....m. (approximate if not unpiled)
- A.....set in conc/rock has been placed/found, bearing.....° M from Mast/Plug/Pillar
- A.....set in conc/rock has been placed/found, bearing.....° M from Mast/Plug/Pillar
- A.....set in conc/rock has been placed/found, bearing.....° M from Mast/Plug/Pillar
- A.....set in conc/rock has been placed/found, bearing.....° M from Mast/Plug/Pillar
- Action required:.....


STANDPOINT:

Mark	Direction	Horiz. Distance	Height Difference	Mark	Direction	Horiz. Distance	Height Difference
			above standpt.				above standpt.
			below				below
			above standpt.				above standpt.
			below				below
Prepared by: *W. Miller* 21.2.19 Checked: *Checked*
 Noted on U.T.M. Card

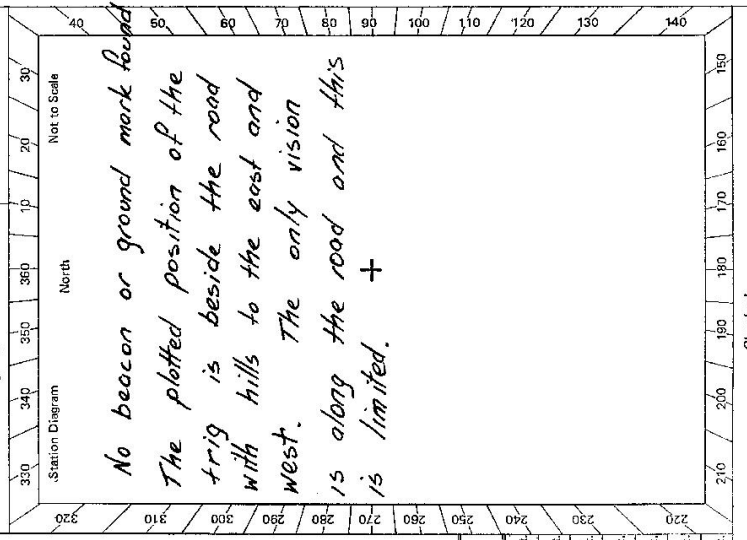

Sr 2738-2 D. West, Government Printer

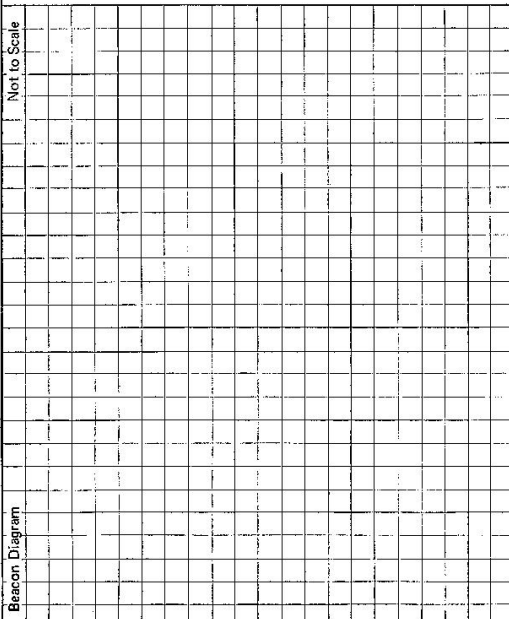STATION	BRANSBY	1137
Owner's Name: Address: Phone:	Current Occupant: Address: Phone:	<p style="text-align: center;">ACCESS</p> <p>Access Report of 27.1.1978 was found suitable/unsuitable.</p> <p style="text-align: center;"><i>On the Monaro Highway at the turnoff to Michelago travel north for 5.5km. On the right hand side there is a dirt road and a bridge over the railway. The trig site is about 50m south of the bridge between the road and the railway.</i></p>
Beacon Diagram 	<p>This section to be completed by officer constructing pillar.</p> <p>Original station mark found/not found.</p> <p>Description of mark:</p> <p>Original beacon found/not found.</p> <p>Description of beacon:</p> <p>Height Top of Vane to Top Mark.....m.</p> <p>Height of mark.....m. above rock/conem. below G.L.</p> <p>Diameter of Vanem. Height of Cairnm.</p> <p>Original Beacon has/has not been destroyed by me.</p>	
		Record of Station
		Date
		12.1.79 <i>Not Found</i>