

75-103

Department of Lands
 Integration : y of N.S.W.
 RECONNAISSANCE and MAINTENANCE REPORT 1138
 STATION BRANKTON PILLAR 1138

Co: NORTHUMBERLAND Ph: BELFORD
 Map Sheet: CESVUOK No: 9132
 Inspected by: M. BRAMLEY Date: 29. 1. 76
 Authority: I.S.D. (NEWCASTLE) Field Book: 3357PPR

Note: Cross out word or words which do not apply

This Trig. Station has been:-


1. Completely cleared to permit 360° vision to surrounding Trigs. ✓
2. Cleared by ~~lines bearing~~ from Trig-Mast
3. Trig. Mast & Vanes have been painted white & black respectively. ✓
4. The Trig. was unpiled/~~not-unpiled~~, dimensions now being:

Description of mark: CONCRETE PILLAR should be explicit, e.g. Steel plug, Brass plug, Bolt, Concrete Pillar
 Height of mark: 0.00 m above rock-concrete 1.23 m above G.L.
 Height of Top Vanes to Top Mast/Top pillar plate 1.43 m Diameter of Vanes (vertical) 0.75 m.
 Height of Pillar 1.23 m. Diameter of Cairn m.
 Length of Mast 1.52 m. (approximate if not unpiled)

5. A Trig. Hole, ~~set in conc/rock~~ has been placed/fd 2.487 m. bearing 270 °M from Trig. ~~Mast~~/pillar
6. A G.I.P. ~~set in conc/soil~~ has been placed/fd 1.227 m. bearing 340 °M from Trig. ~~Mast~~/pillar
7. A C.S. ~~set in conc/soil~~ has been placed/fd 2.104 m. bearing 90 °M from Trig. ~~Mast~~/pillar
8. A ~~set in conc/rock~~ has been placed/fd m. bearing °M from Trig. Mast/pillar
9. Connection Trig Hole to G.I.P. : 2.876 m. bearing 42 °M
10. Connection Trig Hole to C.S. : 4.589 m. bearing 88 °M
11. Connection ~~to~~ to m. bearing °M
12. Connection ~~to~~ to m. bearing °M
13. Diff. Ht. Trig Hole is 1.31 m. ~~above~~ below PILLAR PLATE
14. Diff. Ht. G.I.P. is 1.215 m. ~~above~~ below PILLAR PLATE
15. Diff. Ht. C.S. is 1.206 m. ~~above~~ below PILLAR PLATE
16. Diff. Ht. G.I.P. is 0.096 m. ~~above~~ below BRASS PLUG. C.S. is 0.105 ABOVE BRASS PLUG.

Prepared by: MB

Checked: A. BURROWS

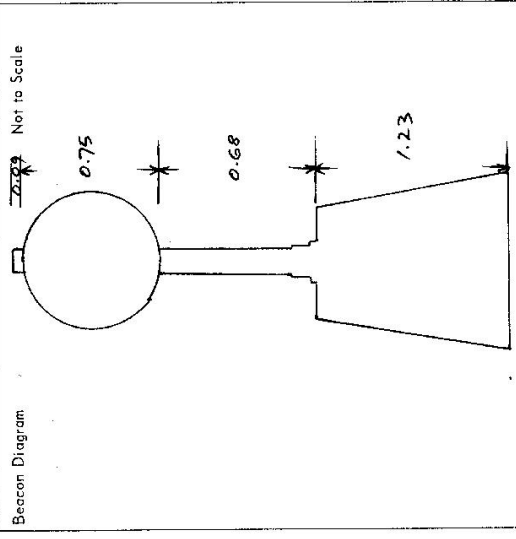

Date	Record of Station
Aug 72	Pillar erected

STATION BRANXTZ PILLAR 1138


Owners Name: Current Occupant:

Address: Address:

Access 29-1-76
 Travel to west Singleton from Branxton along New England Uighway.

Access	MILEAGE (km)	FEATURE
0.00		SIGN POST STANFORDS LOWER BELFORDS TURN RIGHT. (APPROX 26 km from Pillar)
1.50		TURN LEFT THROUGH WHITE WOODEN GATE WHICH IS JUST PAST WHITE CONCRETE WATER TANK ON RIGHT. FOLLOW CLEARLY DEFINED TRACK THROUGH Paddock.
2.25		TAKE LEFT FORK.
2.50		TRIG.

ACCESS EASY BY 2 WHEEL DRIVE

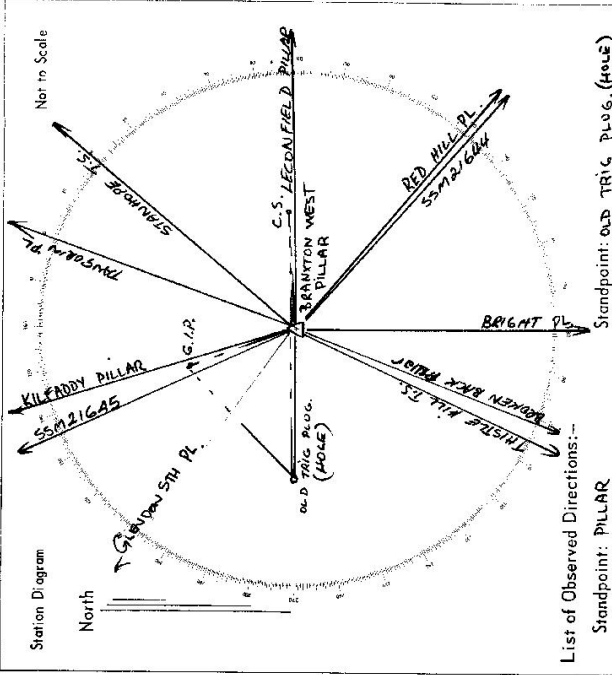

List of Observed Directions:-

Station	Direction	Station	Direction
LEGONFIELD PL	0° 00' 00"	LEGONFIELD PL	0° 00' 00"
RED HILL PL	46° 23' 33.8"	RED HILL PL	46° 23' 33.8"
SSM 21644	48° 12' 27.08"	BRIGHT PL	92° 11' 46.3"
TRIG PLOG HOLE	179° 10' 40.0"	BROOKHURST PL	115° 53' 49.0"
GLENDON STA PILLAR	212° 22' 02.0"	THISTLE HILL TS	179° 58' 58.26"

Station	Direction	Station	Direction
GIP	249° 21' 10"	KILFADDY PL	25° 00' 07.13"
TANQUOBIN PL	286° 42' 36.33"	SIP	314° 23' 13"
STANHOPE TS	308° 10' 09.4"	STANHOPE TS	308° 10' 09.5"
C.S.	329° 59' 38.0"	PILLAR	329° 10' 37.0"
		C.S.	339° 32' 35.4"

CENTRAL MAPPING AUTHORITY

GEODETIC SURVEY OF N.S.W.
 GEODETIC STATION RECONNAISSANCE and MAINTENANCE REPORT


STATION: **BRANKTON (Pillar)** No.: **1138**

MAP SHEET SCALE 1:250 000

INSPECTED BY: **D.J. Kain** DATE: **17 April 1972**

AUTHORITY: **C.M.A.** FIELD BOOK: **1673**

Station Diagram

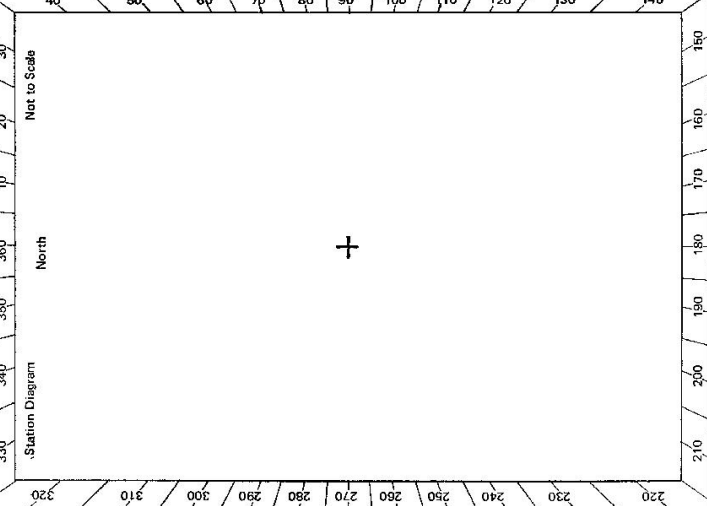


Description:
 1. Cleared by lanes bearing... *Note: Cross out word or words which do not apply*
 2. Mast & Vanes have been painted white & black respectively.
 3. The station/pillar was...
 Description of mark...
 Height of mark...
 Height of Top Vanes to Top...
 Height of Cairn...
 Length of Mast...
 4. A...
 5. A...
 6. A...
 7. A...
 8. Action required:

STANDPOINT:				
Mark	Direction	Horiz. Distance	Height Difference	Direction
			above standpt.	above standpt.
			below	below
			above standpt.	above standpt.
			below	below
Prepared by: *[Signature]* Checked: *[Signature]* Noted on U.T.M. Card

Sr 2733-2 D. West, Government Printer

STATION Braxton Pillar 1138

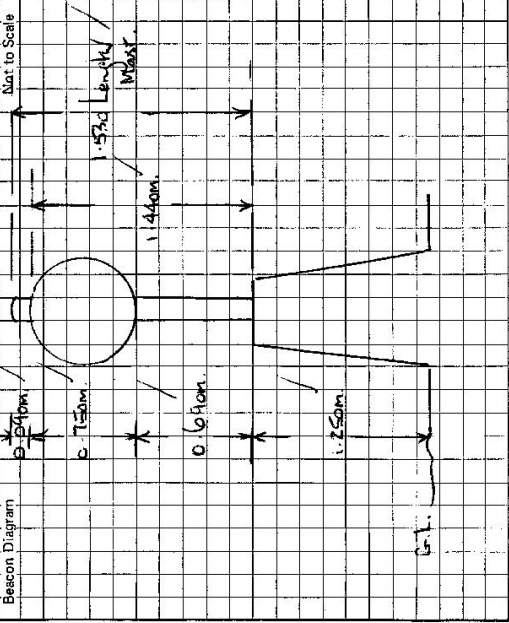

Owner's Name: Mrs. Wilson
 Address: 17 BRAXTON STREET
BLACKTOWN, N.S.W.
 Phone: 6227 2067

Current Occupant:
 Address:
 Phone:

ACCESS
 Access Report of 1.4/1979 was found suitable/unsuitable.

This section to be completed by officer constructing pillar.

Original station mark found/not found.

Description of mark:

Original beacon found/not found.

Description of beacon:

Height Top of Vanes to Top Mark:m.

Height of mark:m. above G.L.
 below

Diameter of Vanesm.

Original Beacon has/has not been destroyed by me.

Date	Record of Station

STATION BRANXTC | PILLAR 1138


Owners Name: Current Occupant:

Address: Address:

Access 29-1-76 Travel to ward Singleton from Branxtion along New England Highway.

MILEAGE (km)
 0.00 SIGN POST STANFORDS LOWER BELFORDS TURN RIGHT. (APPROX 26 km FROM BRANXTION)
 1.50 TURN LEFT THROUGH WHITE WOODEN GATE WHICH IS JUST PAST WHITE CONCRETE WATER TANK ON RIGHT. FOLLOW CLEARLY DEFINED TRACK THROUGH Paddock.
 2.25 TAKE LEFT FORK.
 2.50 TRIG.

ACCESS EASY BY 2 WHEEL DRIVE

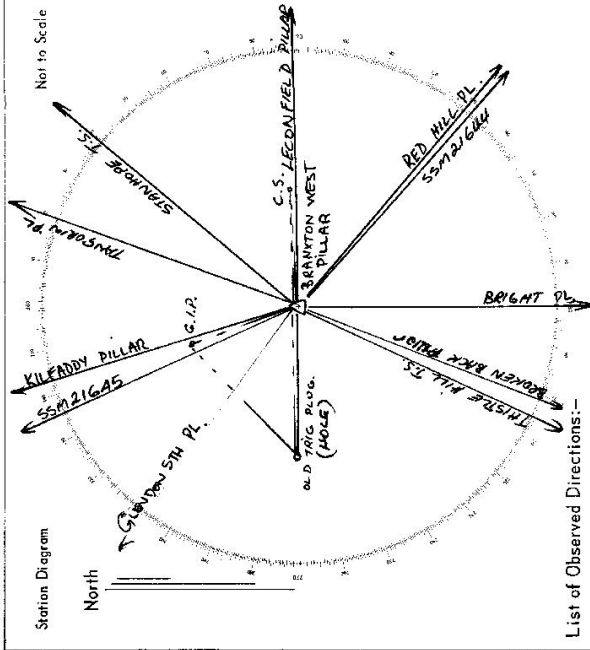

List of Observed Directions:-

Station	Direction	Station	Direction
LEONFIELD PL	0° 00' 80"	LEONFIELD PL	0° 00' 80"
RED HILL PL	46° 23' 52.58"	RED HILL PL	46° 23' 18.47"
SSM 21644	48° 12' 27.08"	BRIGHT PL	92° 11' 46.3"
TRIG PLOG. HOLE	179° 10' 40.0"	BROKENBACK PL	115° 53' 48.00"
GLENDON STN PILLAR	212° 22' 02.0"	THISTLE HILL TS	179° 28' 58.26"
GIP	249° 21' 10"	KILLEDDY PL	25° 00' 07.13"
TANBOBIN PL	286° 42' 36.33"	GIP	344° 23' 13"
STANHOPE TS	308° 10' 09.14"	STANHOPE TS	308° 10' 48.5"
C.S.	339° 59' 35.0"	PILLAR	339° 10' 32.0"
		C.S.	339° 32' 35.0"