

CENTRAL MAPPING AUTHORITY

GEODETIC SURVEY OF N.S.W.


GEODETIC STATION RECONNAISSANCE and MAINTENANCE REPORT

STATION: BREST No.: 1154

MAP SHEET SCALE 1:250 000 CANBERRA

INSPECTED BY: G. KEEP DATE: 22/4/80

AUTHORITY: C.M.A. FIELD BOOK:

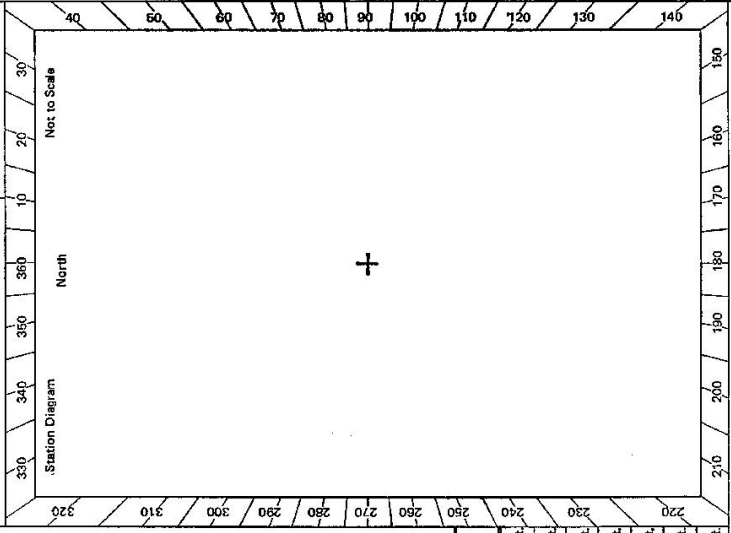

- Description:
1. Cleared by lanes bearing. *Note: Cross out word or words which do not apply*
2. ~~Height of Vanes have been painted white & black respectively.~~
3. The station/pillar was unpiled/not unpiled/constructed on ..... 19 ..... dimensions now being:
- Description of mark ..... should be explicit, e.g., S/Steel Pillar Plate, Steel plug, Brass plug, Bolt, G.I. Pipe
- Height of mark ..... m. <sup>above</sup> / <sub>below</sub> rock/concrete; Mark is ..... m. <sup>above</sup> / <sub>below</sub> G.L.
- Height of Top Vanes to Top Mark/Pillar plate ..... m. Diameter of Vanes (vertical) ..... m.
- Height of Cairn ..... m. Diameter of Cairn ..... m. Name Plate found/not found/placed.
- Length of Mast ..... m. (approximate if not unpiled)
4. A ..... set in conc/rock has been placed/found, bearing ..... ° M from Mast/Plug/Pillar
5. A ..... set in conc/rock has been placed/found, bearing ..... ° M from Mast/Plug/Pillar
6. A ..... set in conc/rock has been placed/found, bearing ..... ° M from Mast/Plug/Pillar
7. A ..... set in conc/rock has been placed/found, bearing ..... ° M from Mast/Plug/Pillar
8. Action required: ~~Needs to be painted black and white, needs clearing for 360° visibility.~~

STANDPOINT:			
Mark	Direction	Horiz. Distance	Height Difference
			above standpt.
			below standpt.
			above standpt.
			below standpt.
Prepared by: G. Keep 4/6/80. Checked: *[Signature]* Noted on U.T.M. Card 11/5/81. Checked

	<b>STATION</b>	<b>BREST</b>		<b>1154</b>
<p>Owner's Name: <b>M. LUTON</b> Current Occupant: .....</p> <p>Address: <b>"ROSEVUE"</b> Address: .....</p> <p>Phone: .....</p> <p style="text-align: center;"><u>ACCESS</u></p> <p>Access Report of <b>24.7.19</b> was found suitable/unsuitable.</p> <p>From Cooma travel towards Shammans Flat. Information on condition of trig. Station obtained from M. Lutons son who owns adjoining property, "Talbaray".</p> <p>Continue past intersection with public hall and ATX (Shammans Flat) for 1km to Rosevee.</p> <p>See owner. Follow dirt road towards Yaouk. Cross over two well used grids.</p> <p>0-00 Grid. Note: As track climbs towards top of hill, it is progressively more eroded.</p> <p>0-54 4WD track to right</p> <p>0-80 Sharp right hand corner in main road.</p> <p>0-82 4WD track to left. Take this track to left.</p> <p>Follow along fence line.</p> <p>0-92 Gate When trig was last visited by owner, trig believed to be complete (mast, vanes and cairn) and standing upright.</p> <p>2-00 Creek</p> <p>2-51 Gate (after creek)</p> <p>2-92 Creek</p> <p>3-28 Take track to left.</p> <p>Follow track up side of hill to gate. Turn right</p> <p>Follow track to top of ridge 15 minute walk to trig</p>				
Record of Station				
Beacon Diagram	Not to Scale			
	This section to be completed by officer constructing pillar.			
	Original station mark found/not found.			
	Description of mark: .....			
	Original beacon found/not found.			
	Description of beacon: .....			
	Height Top of Vanes to Top Mark.....m.			
	above rock/conc.....m. below G.L.			
	Diameter of Vanes.....m. Height of Cairn.....m.			
	Original Beacon has/not been destroyed by me.			
Date				