

CENTRAL MAPPING AUTHORITY

GEODETIC SURVEY OF N.S.W.


GEODETIC STATION RECONNAISSANCE and MAINTENANCE REPORT

STATION: **BRIGALOW** No.: **1159**

MAP SHEET SCALE 1:250,000 **MORÉE (BUINNA BUINNA 1:50,000)**

INSPECTED BY: **J. SUTTON** DATE: **8<sup>TH</sup> NOV. 1979**

AUTHORITY: **C.M.A.** FIELD BOOK: **---**

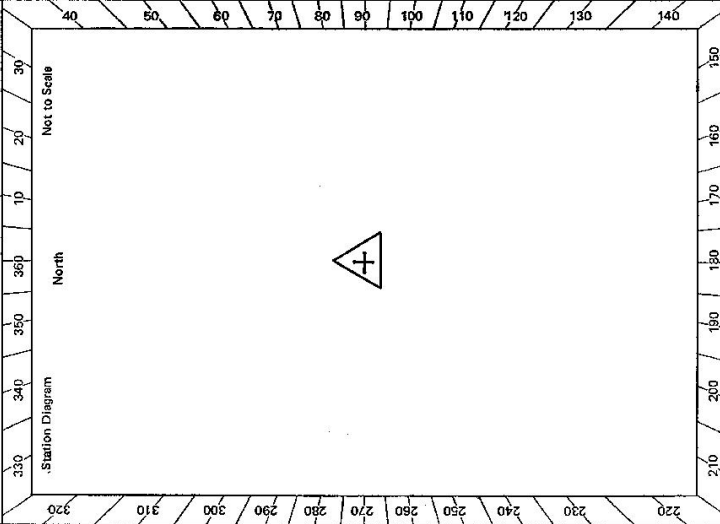

- Description:
- Cleared by lanes bearing  $0^\circ - 36.0^\circ$ . Note: Cross out word or words which do not apply from Trig. Mast
  - Mast & Vanes have been painted white & black respectively. <sup>found</sup>
  - The station/pillar was emptied/not emptied/constructed on  $8.1h$  November 1979. dimensions now being:  
Description of mark  $5.5M$  pro. in conc should be explicit, e.g., S/Steel Pillar Plate, Steel plug, Brass plug, Bolt, G.I. Pipe
- Height of mark  $.....m$ . <sup>above</sup> <sub>below</sub> rock/concrete. Mark is  $.....m$ . <sup>above</sup> <sub>below</sub> G.I.
- Height of Top Vanes to Top Mark/Pillar plate  $.....m$ . Diameter of Vanes (vertical)  $.....m$ .
- Height of Cairn  $.....m$ . Diameter of Cairn  $.....m$ . Name Plate found/not found/placed.
- Length of Mast  $.....m$ . (approximate if not uplied)
- A  $.....$  set in conc/rock has been placed/found, bearing  $.....^\circ$  M from Mast/Plug/Pillar
  - A  $.....$  set in conc/rock has been placed/found, bearing  $.....^\circ$  M from Mast/Plug/Pillar
  - A  $.....$  set in conc/rock has been placed/found, bearing  $.....^\circ$  M from Mast/Plug/Pillar
  - A  $.....$  set in conc/rock has been placed/found, bearing  $.....^\circ$  M from Mast/Plug/Pillar
- Action required: **N!**

STANDPOINT:				STANDPOINT:			
Mark	Direction	Horiz. Distance	Height Difference	Mark	Direction	Horiz. Distance	Height Difference
			above standpt.				above standpt.
			below standpt.				below standpt.
			above standpt.				above standpt.
			below standpt.				below standpt.
			above standpt.				above standpt.
			below standpt.				below standpt.
			above standpt.				above standpt.
			below standpt.				below standpt.

Prepared by: **J. Sutton 8/11/79** Checked: **---** Noted on U.T.M. Card

GS 24

STATION **BRIGALOW** 1159

**NOT TO SCALE**

Line	Placing M	Dist. (m)
①	358	1.17
②	88	19.06
③	40	40.54
④	126	35.22
⑤	152	102.77

Owner's Name: *Dr. Publicus Swatch*  
 Address: .....  
 Phone: .....

Current Occupant: .....  
 Address: .....  
 Phone: .....

ACCESS to Glenarden, Innyade and Mareeba

Access Report of 8/11/1979 was found suitable/unsuitable.

Brigalow G.S. - 55M Pin (No Number) in conc. block found.  
 Pin and block undamaged. Block repainted.

Beacon Diagram

Not to Scale

This section to be completed by officer constructing pillar.

Original station mark found/not found.

Description of mark: .....

Original beacon found/not found.

Description of beacon: .....

Height Top of Vanes to Top Mark ..... m.

Height of mark ..... m. above rock/conc. below G.S.

Diameter of Vanes ..... m. Height of Cairn ..... m.

Original Beacon has/has not been destroyed by me.

Date

Record of Station