

CENTRAL MAPPING AUTHORITY

GEODETIC SURVEY OF N.S.W.

GEODETIC STATION RECONNAISSANCE and MAINTENANCE REPORT

STATION: **BROADFORD** No.: **1162**

Description:

1. Cleared by lanes bearing..... *Note: Cross out word or words which do not apply*
2. Mast & Vanes have been painted white & black respectively,
3. The station/pillar was unpiled/not unpiled/constructed on..... 19..... dimensions now being:
 Description of mark..... should be explicit, e.g., S/Steel Pillar Plate, Steel plug, Brass plug, Bolt, G. I. Pipe
 Height of mark..... m. ^{above} _{below} rock/concrete; Mark is..... m. ^{above} _{below} G. L.
 Height of Top Vanes to Top Mark/Pillar plate m. Diameter of Vanes (vertical)..... m.
 Height of Cairn..... m. Diameter of Cairn..... m. Name Plate found/not found/placed.
 Length of Mast m. ~~Approximate if not unpiled~~
4. A..... set in conc/rock has been placed/found, bearing..... ° M from Mast/Plug/Pillar
5. A..... set in conc/rock has been placed/found, bearing..... ° M from Mast/Plug/Pillar
6. A..... set in conc/rock has been placed/found, bearing..... ° M from Mast/Plug/Pillar
7. A..... set in conc/rock has been placed/found, bearing..... ° M from Mast/Plug/Pillar
8. Action required:.....


STANDPOINT:

Mark	Direction	Horiz. Distance	Height Difference	Mark	Direction	Horiz. Distance	Height Difference
			above standpt.				above standpt.
			below standpt.				below standpt.
			above standpt.				above standpt.
			below standpt.				below standpt.
Prepared by: *G. Hanna* 16/5/79 Checked: *[Signature]*


Noted on U.T.M. Card

SI 2733-1

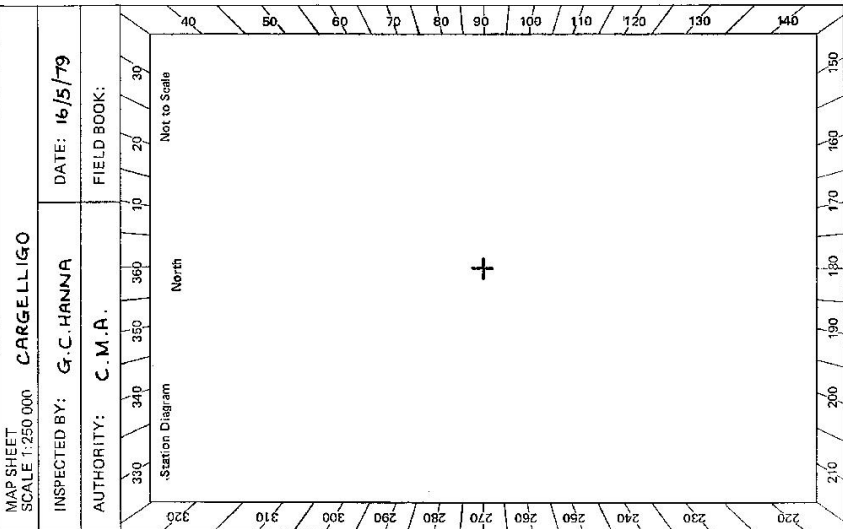

St 2735-2 D. West, Government Printer

Beacon Diagram

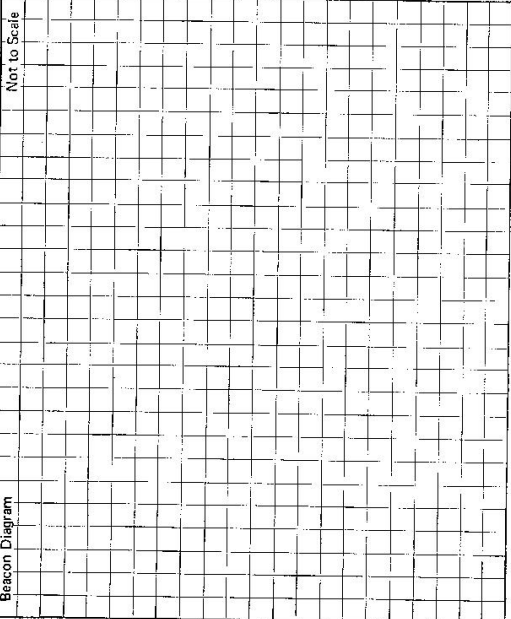

This section to be completed by officer constructing pillar.

Original station mark found/not found.

Description of mark:

Original beacon found/not found.

Description of beacon:

Height Top of Vanes to Top Mark.....m.

Height of mark.....m. above rock/cone.....m. below G.L.

Diameter of Vanes.....m. Height of Cairn.....m.

Original Beacon has/has not been destroyed by me.

STATION

BROADFORD

1162

Owner's Name:
 Current Occupant:

Address:
 Address:

Phone:
 Phone:
 Phone:

ACCESS See Goolgawji 8030-S

Access Report of 14/5/1979 was found suitable/unsuitable.

Trig previously visited 1971
 Cairn was unplied & no ground mark was evident
 Can be driven to from main road

Date

Record of Station