

GEODETTIC SURVEY OF NS.W.

CENTRAL MAPPING AUTHORITY

GEODETTIC STATION RECONNAISSANCE and MAINTENANCE REPORT

Description:

1. Cleared by lanes bearing.....  
 Note: Cross out word or words which do not apply  
 from Trig. Mast

2. Mast & Vanes have been painted white & black respectively.

3. The station/pillar was unpiled/not unpiled/constructed on.....19....., dimensions now being:

Description of mark.....should be explicit, e.g., S/Steel Pillar Plate, Steel plug, Brass plug, Bolt, G.I. Pipe

Height of mark.....m. above below rock/concrete; Mark is.....m. above below G.L.

Height of Top Vanes to Top Mark/Pillar plate.....m. Diameter of Vanes (vertical).....m.

Height of Cairn.....m. Diameter of Cairn.....m. Name Plate found/not found/placed.

Length of Mast.....m. (approximate if not unpiled)

4. A.....set in conc/rock has been placed/found, bearing.....°M from Mast/Plug/Pillar

5. A.....set in conc/rock has been placed/found, bearing.....°M from Mast/Plug/Pillar

6. A.....set in conc/rock has been placed/found, bearing.....°M from Mast/Plug/Pillar

7. A.....set in conc/rock has been placed/found, bearing.....°M from Mast/Plug/Pillar

8. Action required:.....

STANDPOINT:

STANDPOINT:

Mark	Direction	Horiz. Distance	Height Difference	Mark	Direction	Horiz. Distance	Height Difference
			above standpt.				above standpt.
			below standpt.				below standpt.
			above standpt.				above standpt.
			below standpt.				below standpt.
Prepared by:

Checked:

Noted on U.T.M. Chart

Checked

STATION: BROOKS NOSE No.: 1171  
 MAP SHEETS SCALE 1:250 000  
 INSPECTED BY: ? DATE: 13-7-73  
 AUTHORITY: C.M.A. FIELD BOOK:

Not to Scale

<p>STATION <b>BROCKERS NOSE 1171</b></p>	<p>Owner's Name: .....</p> <p>Address: .....</p> <p>Phone: .....</p>	<p>Current Occupant: .....</p> <p>Address: .....</p> <p>Phone: .....</p>	
<p>Access Report of <b>27/1/2023</b> was found suitable/unsuitable.</p>			<p>Date: .....</p>
<p>Not to Scale</p> <p>0.0 kms Junction Picton Road, Mt. Ousley Road Travel towards Bulli Heights.</p> <p>1.3 kms Turn right onto track at crest of hill Locked gate (M.W.S. &amp; D.B. Key)</p> <p>2.3 kms Transmission line with steel towers Travel along main track (CAUTION: many tracks lead off main one.)</p> <p>4.0 kms BROCKERS NOSE G.S.</p> <p>Note: Track four wheel drive after rain.</p>			<p>This section to be completed by officer constructing pillar.</p> <p>Original station mark found/not found.</p> <p>Description of mark: .....</p> <p>Original beacon found/not found.</p> <p>Description of beacon: .....</p> <p>Height Top of Vanes to Top Mark.....m.</p> <p>Height of mark.....m. above / below rock/conc.....m. above G.L. / below G.L.</p> <p>Diameter of Vanes.....m. Height of Cairn.....m.</p> <p>Original Beacon has/has not been destroyed by me.</p>

GEODETTIC SURVEY OF N.S.W.

CENTRAL MAPPING AUTHORITY

GEODETTIC STATION RECONNAISSANCE and MAINTENANCE REPORT

STATION: **BROKERS NOSE (P)** No.: **1171**


Description:  
 1. Cleared by lances bearing.....  
 Note: Cross out word or words which do not apply  
 from Trig. Mast

MAP SHEET  
 SCALE 1:250 000  
 WOLLONGONG

INSPECTED BY: **H.C. BOERBER** DATE: **1-2-19**

AUTHORITY: **C.M.A** FIELD BOOK: **DLBSS**

2. Mast & Vanes have been painted white & black respectively.
3. The station/pillar was unpiled/not unpiled/constructed on.....19....., dimensions now being:  
 Description of mark.....should be explicit, e.g., S/Steel Pillar Plate, Steel plug, Brass plug, Bolt, G.I. Pipe  
 Height of mark.....m. <sup>above</sup> <sub>below</sub> rock/concrete; Mark is.....m. <sup>above</sup> <sub>below</sub> G.L.  
 Height of Top Vanes to Top Mark/Pillar plate .....m. Diameter of Vanes (vertical).....m.  
 Height of Cairn.....m. Diameter of Cairn.....m. Name Plate found/not found/placed.  
 Length of Mast.....m. (approximate if not unpiled)
4. A.....set in conc/rock has been placed/found, bearing.....°M from Mast/Plug/Pillar
5. A.....set in conc/rock has been placed/found, bearing.....°M from Mast/Plug/Pillar
6. A.....set in conc/rock has been placed/found, bearing.....°M from Mast/Plug/Pillar
7. A.....set in conc/rock has been placed/found, bearing.....°M from Mast/Plug/Pillar
8. Action required:.....

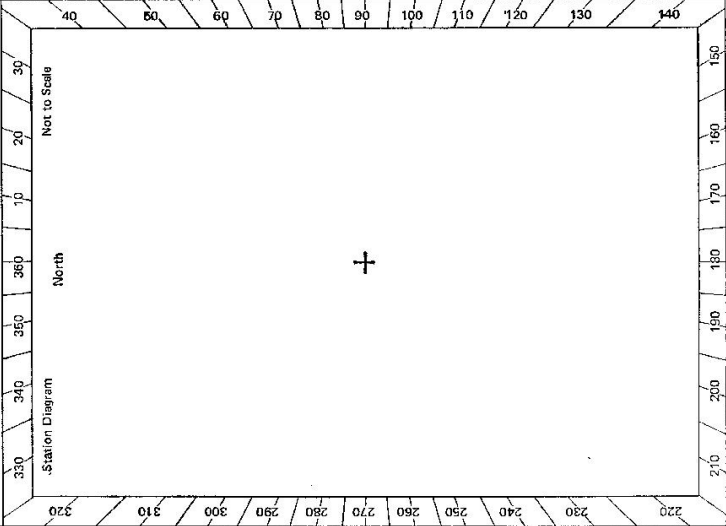


STANDPOINT:

Mark	Direction	Horiz. Distance	Height Difference	Mark	Direction	Horiz. Distance	Height Difference
			above standpt.				above standpt.
			below				below
			above standpt.				above standpt.
			below				below
Prepared by: *[Signature]* Checked: *[Signature]* Noted on U.T.M. Card

St 2733-2 D. West, Government Printer

STATION **BROKERS NOSE PILLAR 171**

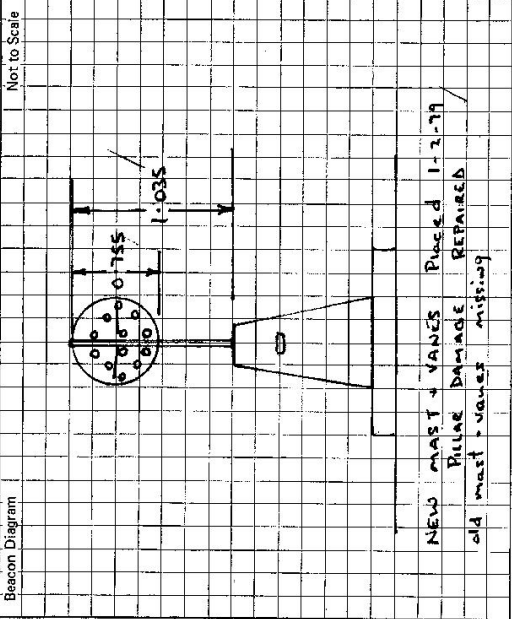

Owner's Name: .....  
 Address: .....  
 Phone: .....

Current Occupant: .....  
 Address: .....  
 Phone: .....

ACCESS  
 Access Report of 1.7.1979 was found suitable/unsuitable.

This section to be completed by officer constructing pillar.

Original station mark found/not found.

Description of mark: .....

Original beacon found/not found.

Description of beacon: .....

Height Top of Vanes to Top Mark.....m.

Height of mark.....m. above rock/conc. ....m. below G.L.

Diameter of Vanes .....m.

Original Beacon has/has not been destroyed by me.

Date	Record of Station

EN 2233-2 D. Issued: Government Printer

Beacon Diagram	Not to Scale
<p>RURAL FIRE SERVICE HAS KEY FOX GATE MICHAEL GARY PH 02 428 48 596 FAX 02 428 33 197 PRINCESS HWY BULLI ACCESS VIA DUMSELL RD OPP WORKERS CLUB</p>	
<p>This section to be completed by officer constructing pillar.</p>	
Original station mark found/not found.	
Description of mark: .....	
Original beacon found/not found.	
Description of beacon: .....	
Height Top of Vanes to Top Mark: .....m.	
Height of mark: .....m. above rock/conc. ....m. above G.L. below .....	
Diameter of Vanes: .....m. Height of Cairn: .....m.	
Original Beacon has/has not been destroyed by me.	

<p>Owner's Name: <u>BHP / ALLIED MINING</u></p> <p>Address: <u>BOX SEPHERT ALLIED MINING</u></p> <p>Phone: <u>04 18 217 362</u></p> <p>Access Report of: ...../19..... was found suitable/unsuitable.</p> <p style="text-align: center;"><u>ACCESS</u></p> <p><u>July 2000</u></p> <p>1171 Brokers Nose (P)</p> <p>This trig can only be accessed while travelling south (conc Barrier on road)</p> <p>0.00 Bulli Road house travel south towards Wollongong 0.4 Bulli Mount road on left 2.3 Under first set of power lines 6.3 Cataract Creek 7.5 Just before large road sign Picton exit 1KM 8.4 Turn left through gate LOCKED 9.0 Cross roads and under power lines 9.9 Pass road on left At parking area near trig</p>	<p style="text-align: center;">STATION <u>BROKERS NOSE (P) 1171</u></p> <p>Current Occupant: .....</p> <p>Address: .....</p> <p>Phone: .....</p> <p>INSPECTED BY: <u>G FORD</u> DATE: <u>12/7/00</u></p> <p>Record of Station</p> <p><u>GFS GEAR</u></p> <p><u>ACCESS ONLY</u></p>
---	--