


St 2733-2 D. West, Government Printer

STATION Beathies G.S. 1179

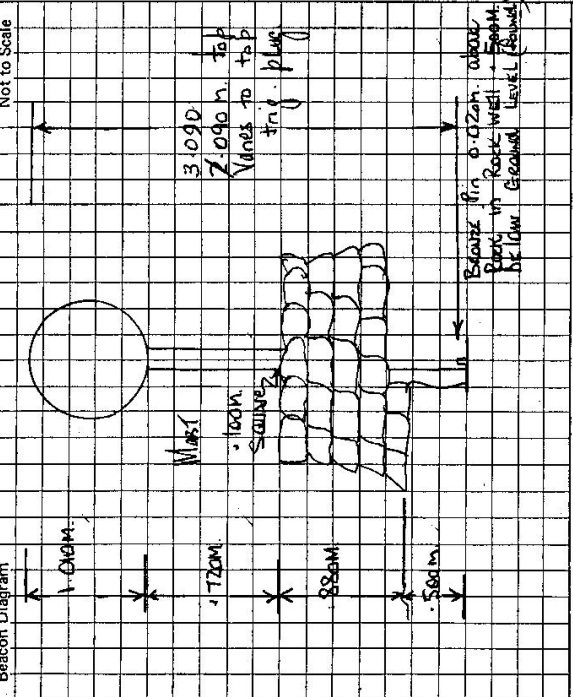

Owner's Name: DUNIKRUM
 Address:
 Phone:

Current Occupant: MR TOM PARKER (OVERSEAS)
 Address: DUNIKRUM
 Phone: TAYLORS ARM Z6

ACCESS 16-12-1978

Access Report of 257 & 196 was found ~~unsuitable~~/unsuitable.

M Post Office TAYLORS ARM AT 0.0 KILOMETRES TRAVEL TOWARD BUEANAPINE.

KILOMETRES

- 0.80 - TURN LEFT AT SIGNPOST "KEMPSEY VIA HICKEYS CREEK" FEATURE.
- 2.05 - PASS CARSONS ROAD ON YOUR R.H.S.
- 4.85 - PASS BAKERS CREEK ROAD AND RUBBISH DUMP ON YOUR L.H.S.
- 5.75 - TURN TO YOUR SHARP RIGHT ONTO TRACK.
- 5.85 - THROUGH LEAN GATE.
- 6.15 - TAKE RIGHT TRACK.
- 6.25 - TAKE LEFT TRACK.
- 6.80 - TAKE LEFT TRACK.
- 6.85 - TAKE RIGHT TRACK.
- 7.25 - TOP OF HILL PASSING TRACK.
- 7.85 - THROUGH BARBED WIRE GATE.
- 8.20 - THROUGH SADDLE IN A WESTEELY DIRECTION ALONG RIDGE

THROUGH LANTANA TO HAIG. ABOUT 20 MINUTES FAIR WALK.

This section to be completed by officer constructing pillar.

Original station mark found/~~not found~~.
 Description of mark: Bronze Plug
 Original beacon found/~~not found~~.
 Description of beacon: Pole CAIRN OF DISCS
MADE RATHER OUT (KEMPSEY)
 Height Top of Vanes to Top Mark: 3.85.....m.
 Height of mark: 0.220 m. above rock/~~base~~ 500 m. ~~above~~ below G.L.
 Diameter of Vanes: 1.010.....m. Height of Cairn: 1.050.....m.

Original Beacon has/~~has not~~ been destroyed by me.

Date Record of Station