

BKL-

Badu Batch 1706

LAND INFORMATION CENTRE

GEODETTIC STATION RECONNAISSANCE and MAINTENANCE REPORT

STATION: BUCKAM BOOL No.: 1203

Description: *Note: Cross out word or words which do not apply*

1. Cleared by lances bearing..... from Trig. Mast

2. Mast & Vanes have been painted white & black respectively.

3. The station/pillar was unplied/~~not unplied~~ on 9th March 1995, dimensions now being:

Description of mark: Brass Plug should be explicit, e.g., S/Steel Pillar Plate, Steel plug, Brass plug, Bolt, G.I. Pipe

Height of mark: 0.040 m. ^{above} rock/concrete; Mark is 0.0 m. ^{above} G.L.

Height of Top Vanes to Top Mark/Pillar-plate 3.620 m. Diameter of Vanes (vertical) 0.91 m.

Height of Cairn..... m. Diameter of Cairn..... m. Name Plate found/not found/placed.

Length of Mast..... m. (approximate if not unplied)

4. A. SSM..... set in conc/rock has been placed/found, bearing 232 M from Mast/Plug/Pillar

5. A. Astro Pillar..... set in conc/rock has been placed/found, bearing 257 M from Mast/Plug/Pillar

6. A..... set in conc/rock has been placed/found, bearing..... M from Mast/Plug/Pillar


7. A..... set in conc/rock has been placed/found, bearing..... M from Mast/Plug/Pillar

8. Action required: Connect tower 22m with into station.....

Mark	Direction	Horiz. Distance	Height Difference	Mark	Direction	Horiz. Distance	Height Difference
R.O. Tower At Buckambool	0°00'00"		above standpt.	R.O. Tower at Buckambool	0°00'00"		above standpt.
SSM IN CONC	282°51'00"	2.783	above standpt.	BRASS PLUG	10°46'50"	2.779	above standpt.
SPIGOT ON ASTRO	307°30'38"	5.083	below standpt.	SPIGOT ON ASTRO	330°59'45"	2.807	below standpt.
* R.O. of tower			above standpt.				above standpt.
			below standpt.				below standpt.

STANDPOINT: BRASS PLUG IN ROCK - STANDPOINT: SSM IN CONC

MAP SHEET SCALE 1:250 000 COBAR
 INSPECTED BY: C. HICKS DATE: March 95
 AUTHORITY: LIC FIELD BOOK: 2111 63C

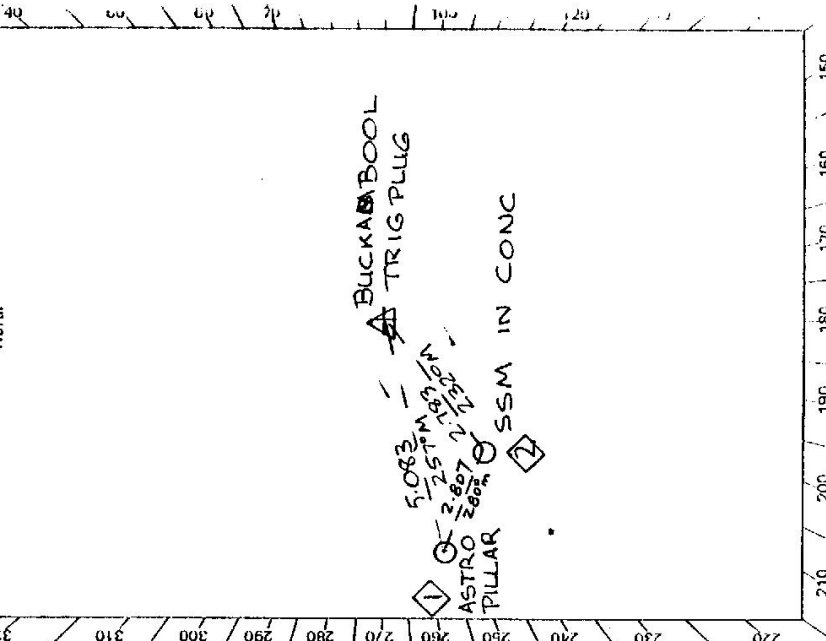

Prepared by: C. Hicks
 Checked: [Signature]
 Noted on U.T.M. Card
 S: 2735-1

