

STATION NAMOONA (Pillar) G.S. TS 5942

Current Occupant Mr. Wilshire

Owners Name Mr. Wilshire

Address R.M.B. BRUSTON

Address R.M.B. BRUSTON

Via Casino, N.S.W.

Via Casino, N.S.W.

Access 21-9-1977 Access to Namoonah Pillar G.S.

AT CASINO AT RAILWAY CROSSING ON KYAGLE ROAD, AT 0.0 KILOMETRES TRAVEL TOWARD KYAGLE.


Kilometres Features:

- 7.40 TAKE GRAVEL DRIVEWAY TO YOUR LEFT AT WHITE CREAM BOX.
- 7.75 PASS HOUSE OF OWNER OF LAND END WHICH PILLAR IS SITUATED ON YOUR RIGHT HAND SIDE.
- 7.90 THROUGH IRON GATE ON L.H.S. OF COW BAILS, FOLLOW TRACK UP GENTLE SLOPE BETWEEN FENCES TO TRIG PILLAR AT 8.30 KILOMETRES

This station is of very easy access and could be driven to by station sedan type vehicle.

Not to Scale

Station Diagram

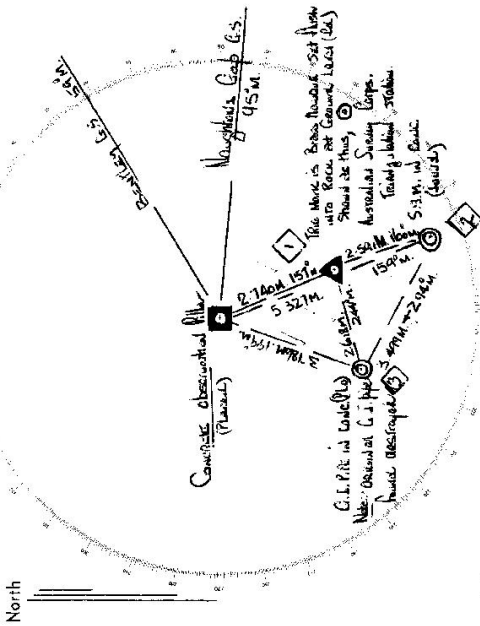

List of Observed Directions:-

Station	Direction	Station	Direction
Naughtons Gap G.S.	0° 00' 00"	CONCRETE OBSERVATIONAL PILLAR	TRIG PILLAR
TRIG PILLAR	67° 59' 00"	Naughtons Gap G.S.	73° 48' 21"
S.S.M.	76° 45' 41"	G.I. PIPE	158° 06' 21"
G.I. PIPE	111° 45' 60"	CONCRETE OBSERVATIONAL PILLAR	247° 59' 42"
Bentley G.S.	327° 04' 59"	BENTLEY G.S.	327° 05' 04"

Station	Direction	Station	Direction

CENTRAL MAPPING AUTHORITY

GEODETIC SURVEY OF N.S.W.


GEODETIC STATION RECONNAISSANCE and MAINTENANCE REPORT

STATION: NARMONNA P No.: 5942

MAPSHEET SCALE 1:250 000 TWEED HERDS

INSPECTED BY: D. FREDRIKSEN DATE: 28/4/80

AUTHORITY: C. M. R. FIELD BOOK: 1873

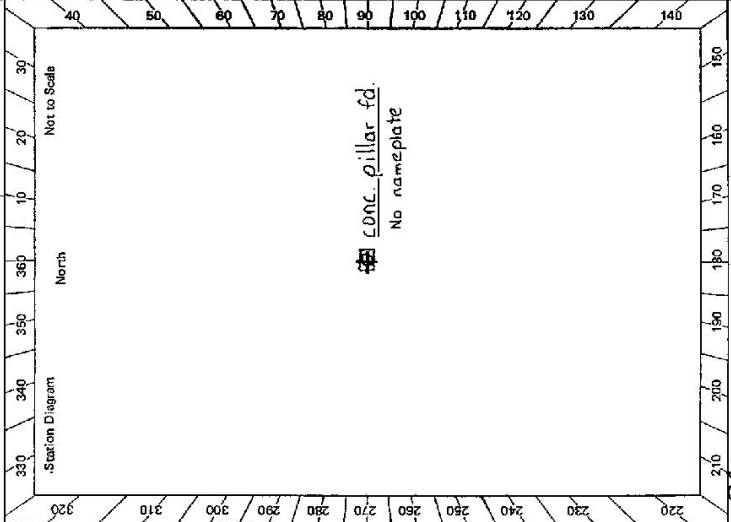

Description: *Note: Cross out word or words which do not apply*

- Cleared by lanes bearing... *cleaning... required...* from Trig. Mast
- Mast & Vanes have been painted white & black respectively.
- The station/pillar was unpiled/not unpiled/constructed on... 19... dimensions now being:

Description of mark/s. *Pillar Plate*... should be explicit, e.g. S/Steel Pillar Plate, Steel plug, Brass plug, Bolt, G.I. Pipe

Height of mark... m. *above* rock/concrete; Mark is... m. *above* G.L.

Height of Top Vanes to Top Mark/Pillar plate... m. Diameter of Vanes (vertical)... m.

Height of Cairn... m. Diameter of Cairn... m. Name Plate found/not found/placed.

Length of Mast... m. (approximate if not unpiled)

- A... G.I. P... set in conc/feek has been placed/found, bearing... M from Mast/Plug/Pillar 3.79 m
- A... S.S.M... set in conc/feek has been placed/found, bearing... M from Mast/Plug/Pillar 5.33 m
- A... B.A.S.C... set in conc/feek has been placed/found, bearing... M from Mast/Plug/Pillar 2.74 m
- A... set in conc/rock has been placed/found, bearing... M from Mast/Plug/Pillar

B. Action required: *Place nameplate; painting*

STANDPOINT: Pillar Plate				STANDPOINT:			
Mark	Direction	Horiz. Distance	Height Difference	Mark	Direction	Horiz. Distance	Height Difference
REQUIREMENTS							
BACRMEDE	47.41 Grid	Mast & Vanes	above standpt	NBODVIEW	211.11 Grid	Wood & Vanes	above standpt
OTHERS				HOBERTH	236.37 "	Timbered range	above standpt
CASINO	149.26 "	P	below standpt	BLACK CAMP	264.54 "	East side range	above standpt
ELLANGOWAN	160.17 "	Timbered ridge	below standpt	THERESA	270.26 "	low range	above standpt
GLEN LUNA	165.43 "	East edge hill	below standpt	DYERBABA	289.25 "	N-end range	below standpt
LEEVILLE	176.16 "	Cairn Mast Vanes	above standpt	ETTRICK	317.53 "	Mast & Vanes	below standpt
SHANNONBROOK	204.08 "	Bald hill	below standpt	EDEN	349.57 "	?	above standpt

Prepared by: D. Fredrikson 14/5/80 Checked: *[Signature]*

Noted on U.T.M. Card

