

74496

CENTRAL MAPPING AUTHORITY
 Department of Lands
 Trigonometrical Survey of N.S.W.
 RECONNAISSANCE and MAINTENANCE REPORT

STATION **BUCKENDERRA G.S. 1205**

Co: _____ Ph: _____

Map Sheet: **BERRIDALE 1:100,000** No: _____


Inspected by: **A. WOODRUFF** Date: **21st JAN 1977**

Authority: **C.M.A.** Field Book: **1530**

Beacon Diagram Not to Scale

This Trig. Station has been:-
 Note: Cross out word or words which do not apply

1. Completely cleared to permit 360° vision to surrounding Trigs.
2. Cleared by lances bearing **360° VISION** from Trig. Mast
3. Trig. Mast & Vanes have been painted **white & black** respectively.
4. The Trig. was unpiled/not unpiled, dimensions now being:
 Description of mark..... should be explicit, e.g. Steel plug, Brass plug, Bolt, G.I. Pipe
 Height of mark..... m ^{above} rock/concrete m ^{below} G.L.
 Height of Top Vanes to Top Mark..... m. Diameter of Vanes (vertical) **0.545** m.
 Height of Cairn..... m. Diameter of Cairn..... m.
 Length of Mast **2.485** m. (approximate if not unpiled)
5. A..... set in conc/rock has been placed..... m. bearing.....°M from Trig. Mast
6. A **G.I. Pipe** set in conc/soil has been placed **19.56** m. bearing **213°M** from Trig. Mast
7. A..... set in conc/soil has been placed..... m. bearing.....°M from Trig. Mast
8. A..... set in conc/rock has been placed..... m. bearing.....°M from Trig. Mast
9. Connection..... to..... m. bearing.....°M
10. Connection..... to..... m. bearing.....°M
11. Connection..... to..... m. bearing.....°M
12. Connection..... to..... m. bearing.....°M
13. Diff. Ht. **G.I. Pipe** is **7.505** m. ^{above} **TOP OF VANES, BUCKENDERRA G.S.**
 below
14. Diff. Ht. is..... m. ^{above} below
15. Diff. Ht. is..... m. ^{above} below
16. Diff. Ht. is..... m. ^{above} below

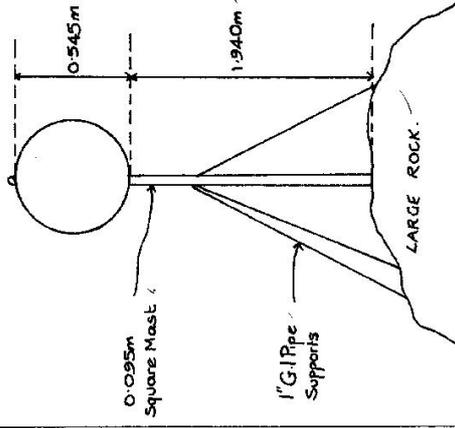

Date _____ Record of Station _____

Prepared by: **Jeff Brown** 12-5-77 Noted on U.T.M. Card

Checked: **Alan Woodruff** 27/3/79

