

STATIONTS 1209S BUCKLE

Owners Name: C. ROWIN

Address: ON T.S. MOUNT


Current Occupant:

Address:

Access: B-78
1:25,000 FIMILICA


Station Diagram

Note: Brass Δ is same mark shown on T.S. MOUNT
BUCKLE maintenance report

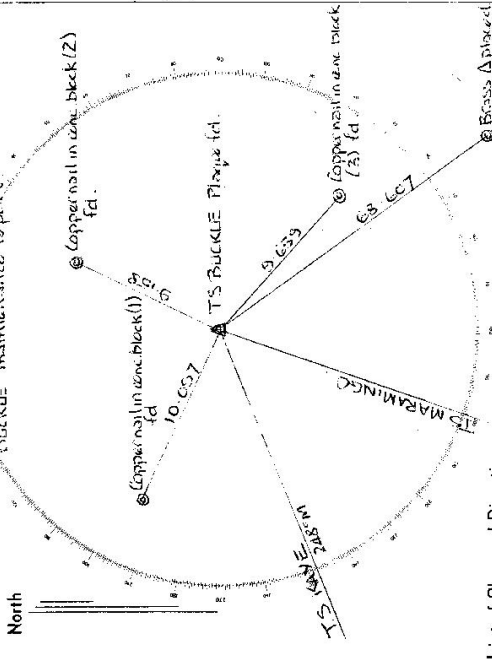

List of Observed Directions:-

Station		Standpoint: Brass Δ	
Station	Direction	Station	Direction
T.S. KAYE	27°00'00"0	T.S. BUCKLE	325°00'00"0
Copper nail 1	49°23'05"	T.S. MOUNT BUCKLE	146°04'13"
Copper nail 2	133°28'34"		
Copper nail 3	245°36'34"		
Brass Δ	257°35'25.2"		
Station		Station	
T.S. MARAMINGO	312°43'03"0		

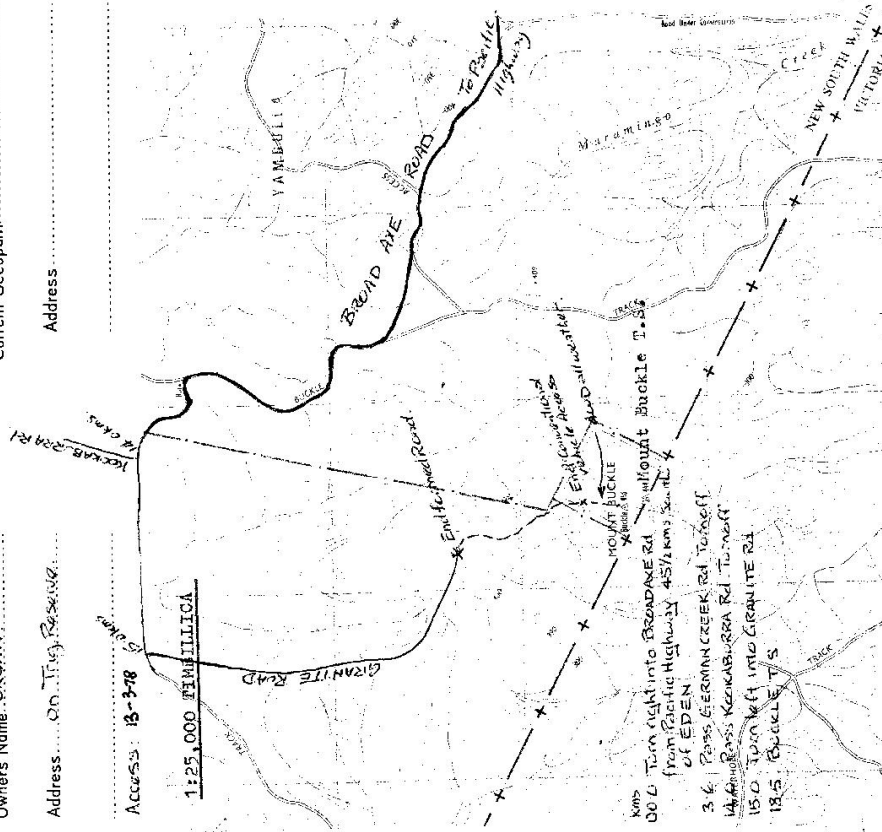

000 Turn right into BROAD AVE Rd
from Pacific Highway 457km South of EDEN
3.4 Pass GERMAN CREEK Rd Turnoff
14km Pass KEENABURGER Rd Turnoff
15.0 Turn left into GRANITE Rd
18.5 BUCKLE T.S.

CENTRAL MAPPING AUTHORITY
 GEODETIC SURVEY OF N.S.W. Batch Id: 1588

SEE MOUNT BUCKLE

GEODETIC STATION RECONNAISSANCE and MAINTENANCE REPORT

STATION: **BUCKLE G5** No.: **1209**

MAP SHEET
 SCALE 1:250 000 **MALLACOOTA**

INSPECTED BY: **W MILLER** DATE: **4-4-19**

AUTHORITY: **CMA** FIELD BOOK: **1559**

Description:
 1. Cleared by lanes bearing **19° 17' 246°** Note: Cross out word or words which do not apply
 from Trig. Mast

2. Mast & Vanes have been painted white & black respectively.

3. The station/pillar was unpiled/not unpiled/constructed on **4-4-19**, dimensions now being:

Description of mark: **Brass Plaque** should be explicit, e.g., S/Steel Pillar Plate, Steel plug, Brass plug, Bolt, G.I. Pipe

Height of mark **0.10** m. above rock/concrete; Mark is **at** m. above G.L.

Height of Top Vanes to Top Mark/Pillar plate **4.23** m. Diameter of Vanes (vertical) **0.910** m.

Height of Cairn **0.00** m. Diameter of Cairn **0.00** m. Name Plate found/not found/placed.

Length of Mast **0.00** m. (approximate if not unpiled)


4. A. Cu. Nail (2) set in conc/rock has been placed/removed, bearing **29.6°** M from Mast/Plug/Pillar

5. A. Cu. Nail (2) set in conc/rock has been placed/removed, bearing **25°** M from Mast/Plug/Pillar

6. A. Cu. Nail (3) set in conc/rock has been placed/removed, bearing **23.3°** M from Mast/Plug/Pillar

7. A. Brass Triangle set in conc/rock has been placed/removed, bearing **143°** M from Mast/Plug/Pillar

8. Action required: **Some scrub clearing**

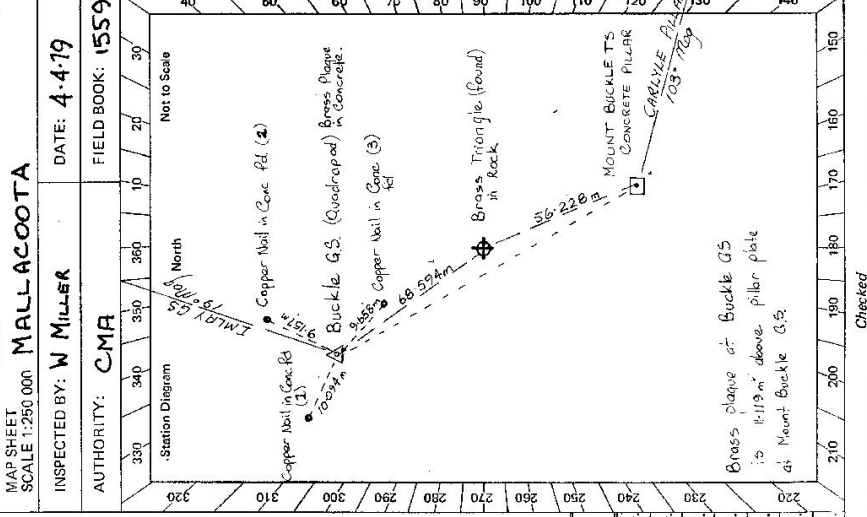

Mark	Direction	Horiz. Distance	Height Difference	Mark	Direction	Horiz. Distance	Height Difference
IMLAY G5	359° 59' 60"		above standpt. 4.827	BUCKLE G5 (Pillar)	359° 59' 60"	68.590	above standpt. 4.827
Cu Nail in Conc. (2)	5° 42' 55"	9.457	below standpt. 0.145	BUCKLE PILLAR	181° 03' 45"	56.227	below standpt. 6.293
Cu Nail in Conc. (3)	111° 50' 20"	9.658	below standpt. 0.762	MOUNT BUCKLE TS			below standpt. 6.290
Brass Triangle Pd	123° 50' 10"	68.597	above standpt. 4.827	STANDPOINT: CONCRETE PILLAR (New Pad)	359° 59' 60"		above standpt. 6.290
Concrete Pillar	124° 19' 25"		below standpt. 0.267	CARLYLE PILLAR	221° 25' 45"		below standpt. 6.290
Cu Nail in Conc. (1)	215° 36' 35"	10.094	above standpt. 0.267	BRASS PLAQUE ALONG BRASS TRIANGLE PL	222° 00' 40"	56.230	above standpt. 6.290
(Distances by Chain ONLY)				BRASS TRIANGLE PL	222° 00' 40"	56.230	above standpt. 6.290

STANDPOINT: BRASS TRIANGLE IN CONCRETE
 STANDPOINT: BRASS TRIANGLE IN ROCK FOUND
 Prepared by: **W MILLER** 11-4-19
 Checked: **W MILLER** 11-4-19
 Noted on U.T.M. Card

STATION **BUCKLE GS 1209**


Owner's Name: **FORESTRY COMMISSION**

Address: **OFFICE AT EDEN**

Phone:
 Access by **Lands Dept.** **ACCESS**
 Access Report of **1.3/19.78** was found suitable/~~unsuitable~~.

Current Occupant:
 Address:
 Phone:

00 km Turn into Broadvale Road from Pacific Highway
4 1/2 kms south of Eden
3.6 Pass German Creek Road turnoff
14.0 Pass Kookaburra Road Turnoff
15.0 Turn left into Granite Road
18.5 Buckle G.S.

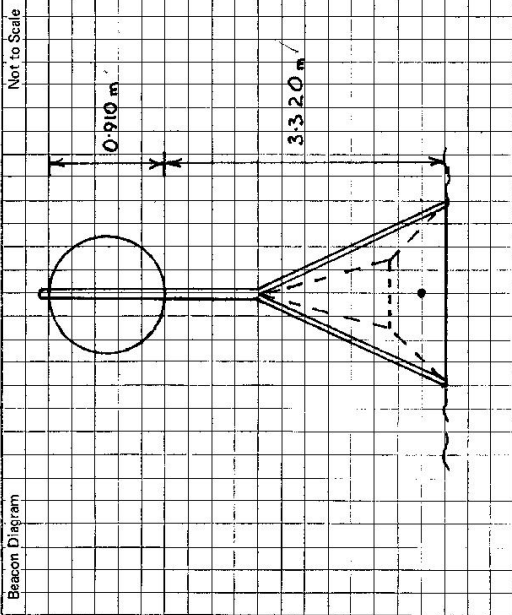

Beacon Diagram

Not to Scale

This section to be completed by officer constructing pillar.

Original station mark found/not found.

Description of mark:

Original beacon found/not found.

Description of beacon:

Height Top of Vanes to Top Mark:m.

Height of mark:m. above G.L. below

Diameter of Vanesm.

Height of Cairnm.

Original Beacon has/has not been destroyed by me.

Date	Record of Station

SEE BUCKLE G.S.

GEODETTIC SURVEY OF N.S.W.

CENTRAL MAPPING AUTHORITY


GEODETTIC STATION RECONNAISSANCE and MAINTENANCE REPORT

STATION: MOUNT BUCKLE T.S. No.: 1209

MAP SHEET SCALE 1:250 000

INSPECTED BY: W MILLER DATE: 4.4.79

AUTHORITY: CMA FIELD BOOK: 1559

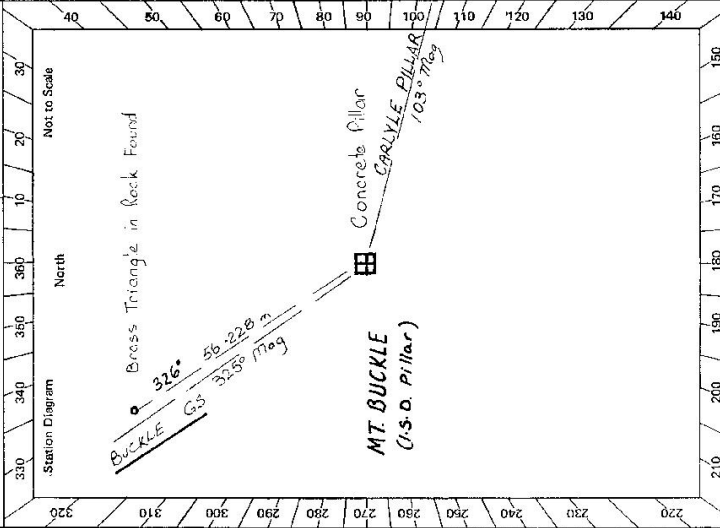

- Description:
- Note: Cross out word or words which do not apply
- Cleared by lanes bearing..... 1.03°..... 2.83°..... from Trig. Mast
 - Mast & Vanes have been painted white & black respectively.
 - The station/pillar was unpiled/not unpiled/constructed on..... 19....., dimensions now being: Description of mark..... ~~BUCKLE PILLAR~~..... should be explicit, e.g., S/Steel Pillar Plate, Steel plug, Bress plug, Bolt, G.I. Pipe Height of mark..... 1.260..... m. above rock/concrete; Mark is..... m. above below G.L.
 - Height of Top Vanes to Top Mark/Pillar plate 1.460..... m. Diameter of Vanes (vertical)..... 0.600..... m.
 - Height of Cairn..... m. Diameter of Cairn..... m. Name Plate found/not found/placed.
 - Length of Mast..... 1.570..... m. (approximate if not unpiled)
 - A..... TRIANGLE..... set in conc/rock has been placed/found, bearing..... 326°..... M from Mast/Bress/Pillar
 - A..... set in conc/rock has been placed/found, bearing..... ° M from Mast/Plug/Pillar
 - A..... set in conc/rock has been placed/found, bearing..... ° M from Mast/Plug/Pillar
 - A..... set in conc/rock has been placed/found, bearing..... ° M from Mast/Plug/Pillar
 - Action required:.....

STANDPOINT: PILLAR PLATE				STANDPOINT:			
Mark	Direction	Horiz. Distance	Height Difference	Mark	Direction	Horiz. Distance	Height Difference
CARLYLE PILLAR	359 52 60		above standpt. below				above standpt. below
BUCKLE G.S.	221 25 45		above standpt. below				above standpt. below
BRESS TRIANGLE IN ROCK	222 00 40	56.228	above standpt. below				above standpt. below
			above standpt. below				above standpt. below
			above standpt. below				above standpt. below
			above standpt. below				above standpt. below
			above standpt. below				above standpt. below

Prepared by: W Miller 11.4.79 Checked: W Miller 27/4/79 Noted on U.T.M. Card

CS

STATION **MOUNT BUCKLE TS 1209**

Owner's Name: **Forestry Commission**
 Address: **Office of Eden**
 Phone:


Current Occupant:

Address:

Phone:

ACCESS
 Access By **LANDS DEPT**
 Access Report of **13.1.2/18.2** was found suitable/unsuitable.

0.0km Turn into Brecklave Road from Pacific Highway
3.6 45 1/2 kms South of Eden
14.0 Pass German Creek Road turnoff
15.0 Pass Kookaburra Road turnoff
18.5 Turn left into Granite Road
18.6 Buckle G.S.
18.6 MtBuckle TS Pillar

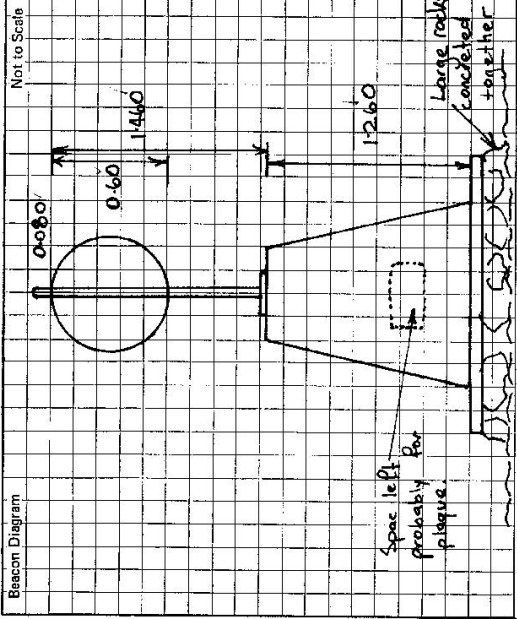

This section to be completed by officer constructing pillar.

Original station mark found/not found.

Description of mark:

Original beacon found/not found.

Description of Beacon:

Height Top of Vanes to Top Markm.

Height of markm. above G.L.
 below

Diameter of Vanesm. Height of Calmm.

Original Beacon has/has not been destroyed by me.

Date	Record of Station

CENTRAL MAPPING AUTHORITY

GEODETIC SURVEY OF N.S.W.

GEODETIC STATION RECONNAISSANCE and MAINTENANCE REPORT

Description:

1. Cleared by lanes bearing.....
 Note: Cross out word or words which do not apply
 from Trig. Mast

2. Mast & Vanes have been painted white & black respectively.

3. The station/pillar was unpiled/not unpiled/constructed on.....19....., dimensions now being:

Description of mark.....should be explicit, e.g., S/Steel Pillar Plate, Steel plug, Brass plug, Bolt, G.I. Pipe

Height of mark.....m. ^{above} rock/concrete; Mark is.....m. ^{below} G.L.

Height of Top Vanes to Top Mark/Pillar plate.....m. Diameter of Vanes (vertical).....m.

Height of Cairn.....m. Diameter of Cairn.....m. Name Plate found/not found/placed.

Length of Mast.....m. (approximate if not unpiled)

4. A.....set in conc/rock has been placed/found, bearing.....° M from Mast/Plug/Pillar

5. A.....set in conc/rock has been placed/found, bearing.....° M from Mast/Plug/Pillar

6. A.....set in conc/rock has been placed/found, bearing.....° M from Mast/Plug/Pillar

7. A.....set in conc/rock has been placed/found, bearing.....° M from Mast/Plug/Pillar

8. Action required:.....

STANDPOINT:

STANDPOINT:

Mark	Direction	Horiz. Distance	Height Difference	Mark	Direction	Horiz. Distance	Height Difference
			above below				above below
			standpt.				standpt.
			above below				above below
			standpt.				standpt.
Prepared by:

Checked:

Noted on U.T.M. Card

Checked

SI 2733-1

STATION: Bucklz GS No.: 1209

MAP SHEET SCALE 1:250 000 Mallacoota

INSPECTED BY: W Miller DATE: 1-4-79



AUTHORITY: CMA FIELD BOOK: 1559

Station Diagram

Not to Scale

St 2733-2 D. West, Governm

Beacon Diagram

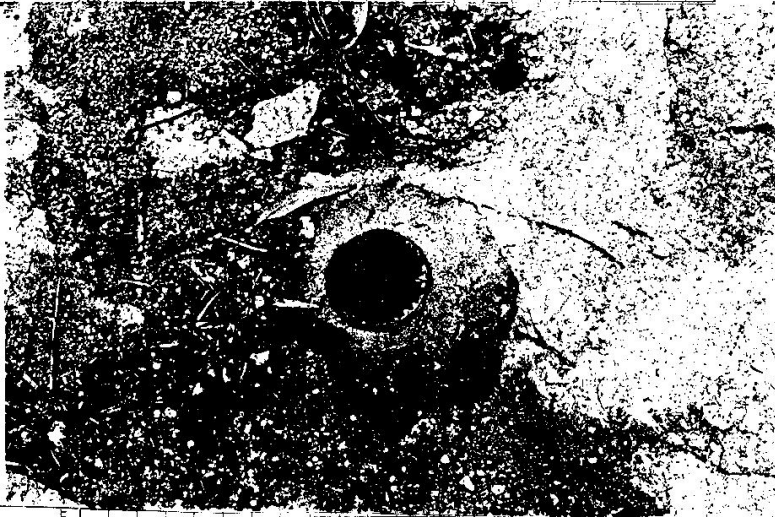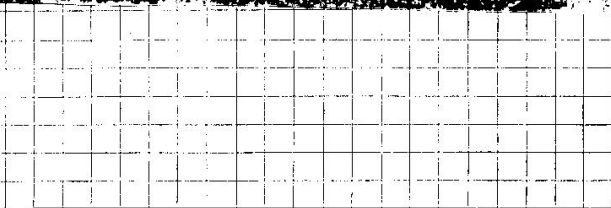

Scale



This section to be completed

Original station mark found/not found.

Description of mark:

Original beacon found/not found.

Description of beacon:

Height Top of Vanes to Top Mark.....m.

Height of mark.....m. above rock/conc.....m. below G.L.

Diameter of Vanesm. Height of Cairnm.

Original Beacon has/has not been destroyed by me.

STATION

Buckle GS

1209

Owner's Name:

Address:


Phone:

Current Occupant:

Address:

ACCESS

Access Report of...../...../19.....was found suitable/unsuitable.

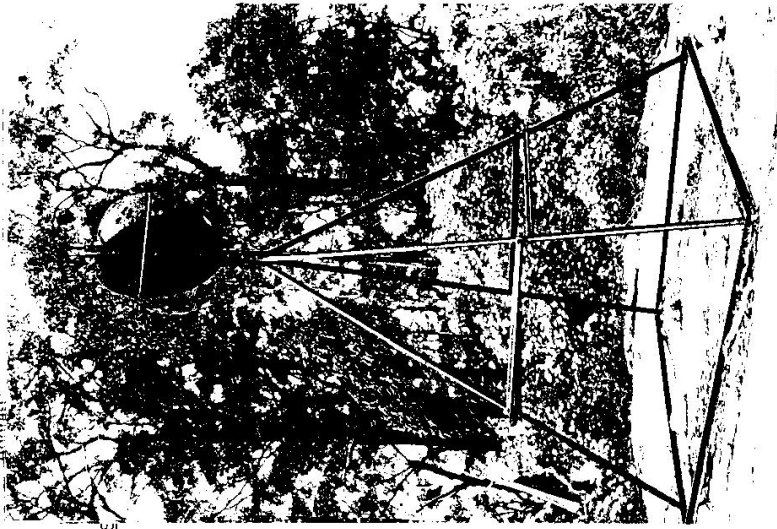

Date

Record of Station
