



LOCALITY SKETCH PLAN

~~PM~~ TS 12096

~~SS~~


MGA E: 529809.453
MGA N: 6270680.737

Replaces PM/SS _____

Datum: ~~MGA94~~ MGA2020 Zone: ~~54/55/56/57/58~~
Coordinates determined by: (AUSPOS / RTK / Handheld GNSS / TRAV) Other: 3D STATE ADJUSTMENT

AHD Level: 340.948 Mark to Ground Level: _____ (ABOVE GROUND / BELOW GROUND)

Height determined by: (~~Diff Levelling / AUSPOS / RTK / Trig Heighting / Handheld GNSS~~) Other: CORS TIE SURVEY

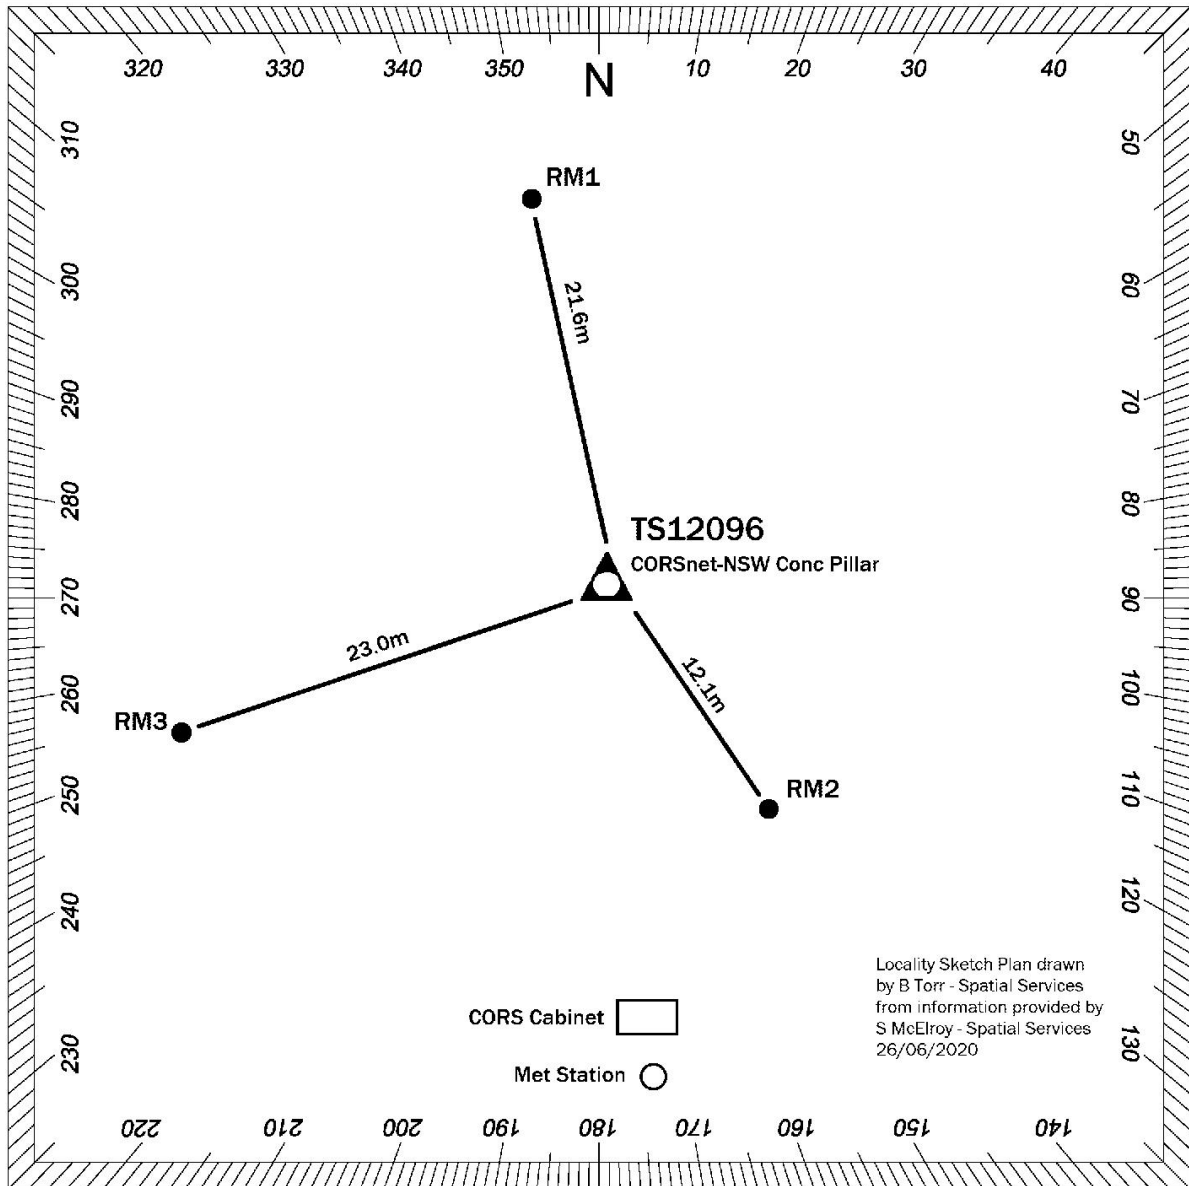

Please use black ink only
Distances shown are in metres

(Refer to Surveyor-General's Direction No. 2 - Preparation of Locality Sketch Plans.)

Town/Suburb/Locality: LAKE COWAL Monument Description: WEST WYALONG CORS PILLAR

I certify that the mark has been placed/found and numbered as detailed hereon.

Name of Organisation _____
placing mark: LAND & PROPERTY INFORMATION

Date mark placed/~~found~~: 01/07/2009

Surveyor's Ref: _____

Name: BRADLEY TORR

Signed: *B.Torr*



LOCALITY SKETCH PLAN

~~PM~~ TS 12096

~~SS~~

MGA E: 529809.453

Replaces PM/SS _____

MGA N: 6270680.737

Datum: ~~MGA94~~ MGA2020

Zone: ~~54/55/56/57/58~~

Coordinates determined by: (AUSPOS / RTK / Handheld GNSS / TRAV)


Other: 3D STATE ADJUSTMENT

AHD Level: 340.948

Mark to Ground Level: _____ (ABOVE GROUND / BELOW GROUND)

Height determined by: (~~Diff Levelling~~ / AUSPOS / RTK / Trig Heighting / Handheld GNSS)

Other: CORS TIE SURVEY

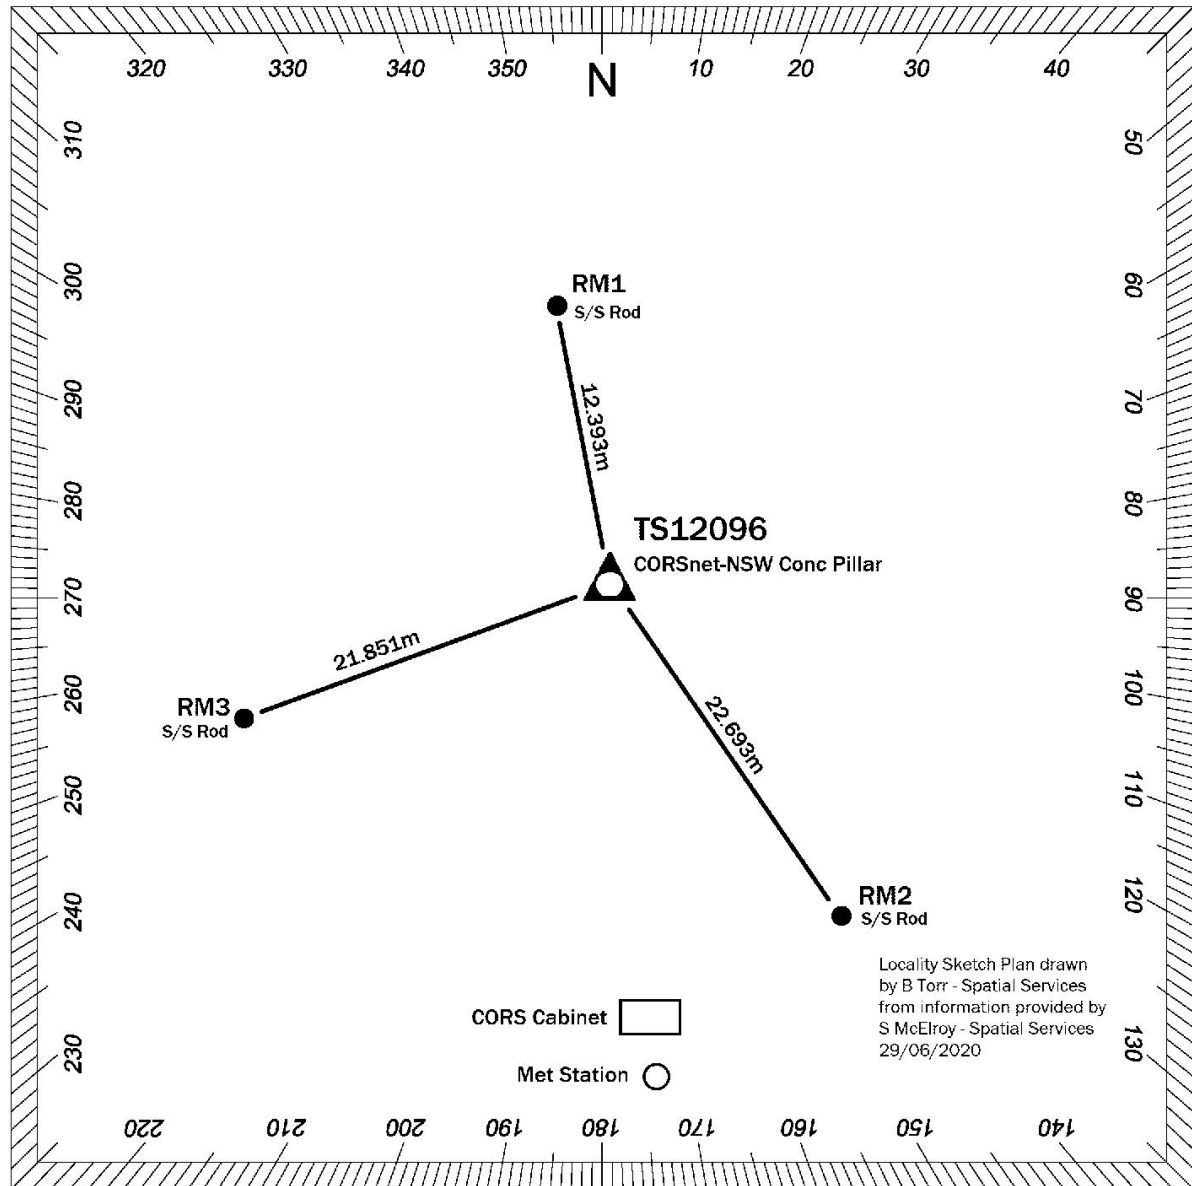

Locality Sketch Plan drawn by B Torr - Spatial Services from information provided by S McElroy - Spatial Services 29/06/2020

Please use black ink only
Distances shown are in metres
(Refer to Surveyor-General's Direction No. 2 - Preparation of Locality Sketch Plans.)

Town/Suburb/Locality: LAKE COWAL

Monument Description: WEST WYALONG CORS PILLAR

I certify that the mark has been placed/found and numbered as detailed hereon.

Name of Organisation _____
placing mark: LAND & PROPERTY INFORMATION

Date mark placed/found: 01/07/2009

Surveyor's Ref: _____

Name: BRADLEY TORR

Signed: *B.Torr*