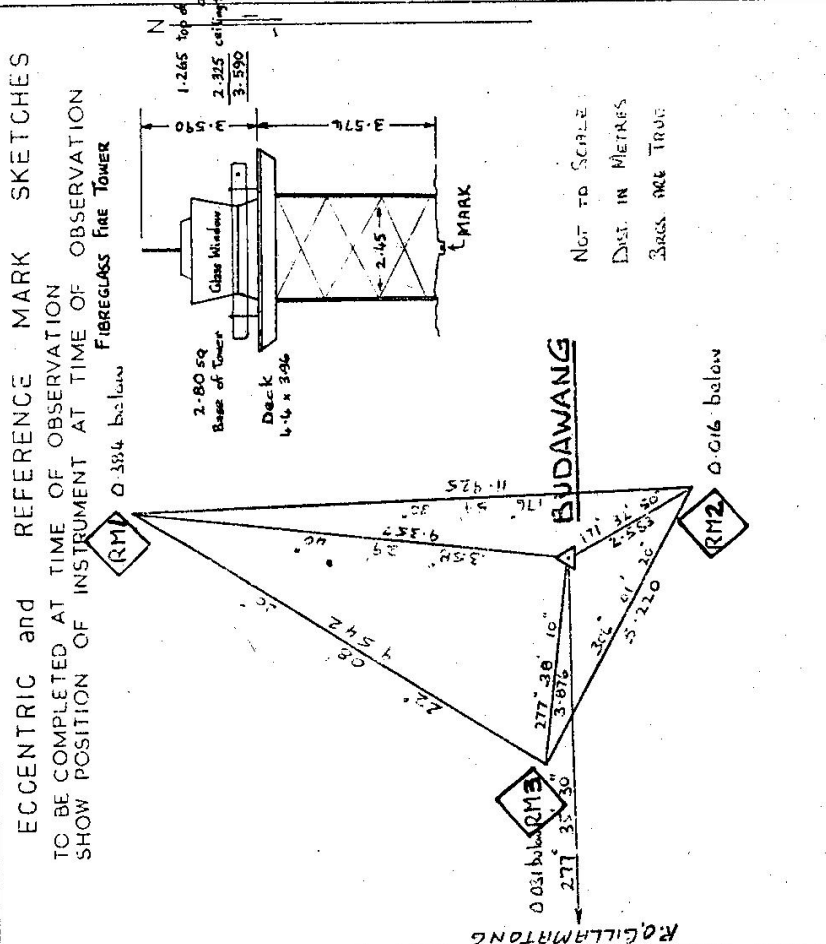
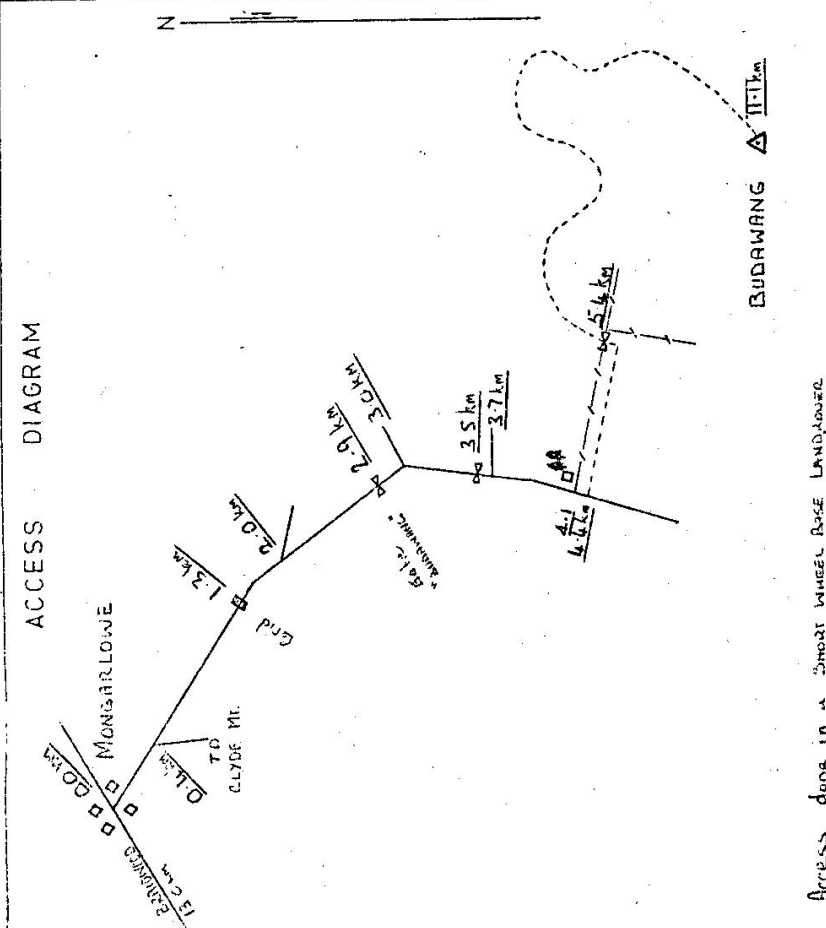


BUDAWANG

TS-1211



STATION	DETAILS
Station Mark	15mm diam. bronze plug set in concrete
Beacon	Fibreglass Fire Tower concentric with Station Mark
Length & Material of Pole	2" DIAM. GI PIPE OF LENGTH 1.265 metres
Eccentric Mark	
Reference Marks	RM1 + RM2 are STAB. PERS. SET IN CONC. RM3 is SSM in CONC.
Vanes	
Vanes Attached	Below Top of

TRANSCRIPTION: CIVIL ENG. 20/5/18

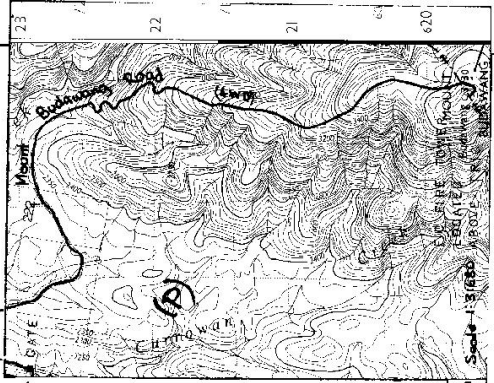
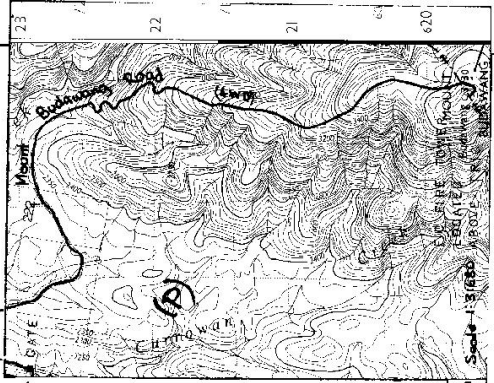
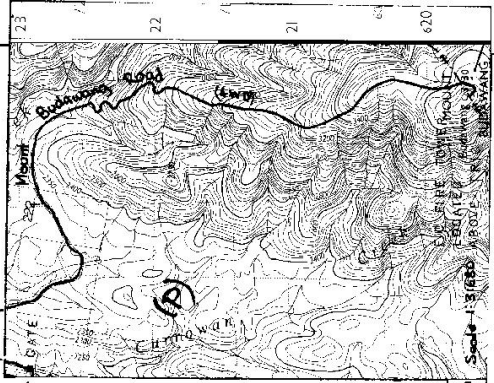
57

TS-1211

REFERENCE MARKS AT BUDAWANG		Theodolite TIA N° 142216 Set Over STATION MARK			Ht. of Instrument 1.630	
Object Sighted	R.O. GILLAMATONG	RM3	SSM	RM1	RM2	STAR PAT. IN CORN.
Horizontal Circle F.L.	0 00 00	00 02 40		80 54 00	253	57 20
F.R.	180 00 00	180 02 40		260 54 20	73	57 20
Horizontal Angle from R.O.	0 00 00	02 40		80 54 10	253	57 20
True Bearing (Instrument to R.O.)	277 35 30	277 35 30		277 35 30	277	35 30
TRUE BEARING TO R.M.	277° 35' 30"	277° 38' 10"		355° 29' 40"	171	32 50
Vertical Circle F.L.		113 12 00		102 09 20	122	30 20
F.R.		246 48 40		257 51 00	237	30 00
Vertical Angle (Elev ⁿ +, Dep ⁿ -)		-23 11 40		-12 09 00	-32	30 10
Slope Distance (Inst. to R.M.)		4.217		9.571	3	063
HORIZONTAL DISTANCE (Inst. to R.M.)		3.876		9.357	2	583
Diff. in Elevation (Axis to R.M.)		1.661		2.014	1	646
HEIGHT ABOVE (+) or BELOW (-) STN. MK		- 0.031		- 0.384	-	0.016
REFERENCE MARKS AT BUDAWANG		Theodolite TIA N° 142216 Set Over STATION MARK			Ht. of Instrument 1.393	
Object Sighted	R.O. RMI	STATION MARK	RM3	SSM	RM2	
Horizontal Circle F.L.	0 00 00	75 29 40		103 53 20		
F.R.	180 00 00	255 30 00		253 53 40		
Horizontal Angle from R.O.	0 00 00	75 29 50		103 53 30		
True Bearing (Instrument to R.O.)	22 08 20	22 08 20		22 08 20		
TRUE BEARING TO R.M.	22° 08' 20"	47° 38' 10"		126° 01' 50"		
Vertical Circle F.L.	100 21 40	109 20 20		104 46 40		
F.R.	259 39 00	250 40 40		255 14 40		
Vertical Angle (Elev ⁿ +, Dep ⁿ -)	- 10 21 20	- 19 19 50		- 14 46 00		
Slope Distance (Inst. to R.M.)	4.699	4.107		5.318		
HORIZONTAL DISTANCE (Inst. to R.M.)	9.541	3.875		5.220		
Diff. in Elevation (Axis to R.M.)	1.743	1.359		1.375		
HEIGHT ABOVE (+) or BELOW (-) STN. MK	- 0.382	+ 0.003		- 0.013		

TS-1211

St 2733-2 D. West, Government Printer

<p>Beacon Diagram</p> <div style="border: 1px solid black; width: 100%; height: 150px; background-image: linear-gradient(to right, black 1px, transparent 1px), linear-gradient(to bottom, black 1px, transparent 1px); background-size: 20px 20px;"> <p style="text-align: right; margin-right: 5px;">Not to Scale</p> </div>	<table border="1" style="width: 100%; border-collapse: collapse;"> <tr> <td style="width: 50%; padding: 5px;"> <p style="text-align: center;">STATION BUDAWANG 1211</p> <p>Owner's Name:</p> <p>Address:</p> <p>Phone:</p> <p>Current Occupant:</p> <p>Address:</p> <p>Phone:</p> <p>Access Report of 30/2/1974 was found suitable/unusable MONGARLOWE Nerriga ACCESS 14.1 km to Braidwood (Mungah Cove Rd.)</p> <p style="text-align: center;">GN</p> <p style="text-align: center;">(NOT TO SCALE)</p> <p style="text-align: center;">Access only. For further information see :- Braidwood 8827-11-S.</p> </td> <td style="width: 50%; text-align: center; vertical-align: middle;">  </td> </tr> <tr> <td style="padding: 5px;"> <p>Date</p> </td> <td style="padding: 5px;"> <p>Record of Station</p> </td> </tr> </table>	<p style="text-align: center;">STATION BUDAWANG 1211</p> <p>Owner's Name:</p> <p>Address:</p> <p>Phone:</p> <p>Current Occupant:</p> <p>Address:</p> <p>Phone:</p> <p>Access Report of 30/2/1974 was found suitable/unusable MONGARLOWE Nerriga ACCESS 14.1 km to Braidwood (Mungah Cove Rd.)</p> <p style="text-align: center;">GN</p> <p style="text-align: center;">(NOT TO SCALE)</p> <p style="text-align: center;">Access only. For further information see :- Braidwood 8827-11-S.</p>		<p>Date</p>	<p>Record of Station</p>
<p style="text-align: center;">STATION BUDAWANG 1211</p> <p>Owner's Name:</p> <p>Address:</p> <p>Phone:</p> <p>Current Occupant:</p> <p>Address:</p> <p>Phone:</p> <p>Access Report of 30/2/1974 was found suitable/unusable MONGARLOWE Nerriga ACCESS 14.1 km to Braidwood (Mungah Cove Rd.)</p> <p style="text-align: center;">GN</p> <p style="text-align: center;">(NOT TO SCALE)</p> <p style="text-align: center;">Access only. For further information see :- Braidwood 8827-11-S.</p>					
<p>Date</p>	<p>Record of Station</p>				
<p>This section to be completed by officer constructing pillar.</p> <p>Original station mark found/not found.</p> <p>Description of mark:</p> <p>Original beacon found/not found.</p> <p>Description of beacon:</p> <p>Height Top of Vanes to Top Markm.</p> <p>Height of markm. above G.L. below</p> <p>Diameter of Vanesm. Height of Cairnm.</p> <p>Original Beacon has/has not been destroyed by me.</p>					