


LOCALITY SKETCH PLAN



Local Government Area BikNL
 Town/Suburb/Locality Draft Sketch + Coords (from Adj)

Office Use - Barcode Including Number Inserted Here

Approx MGA Coordinate: Zone _____ Description of Mark _____
 E: _____
 N: _____

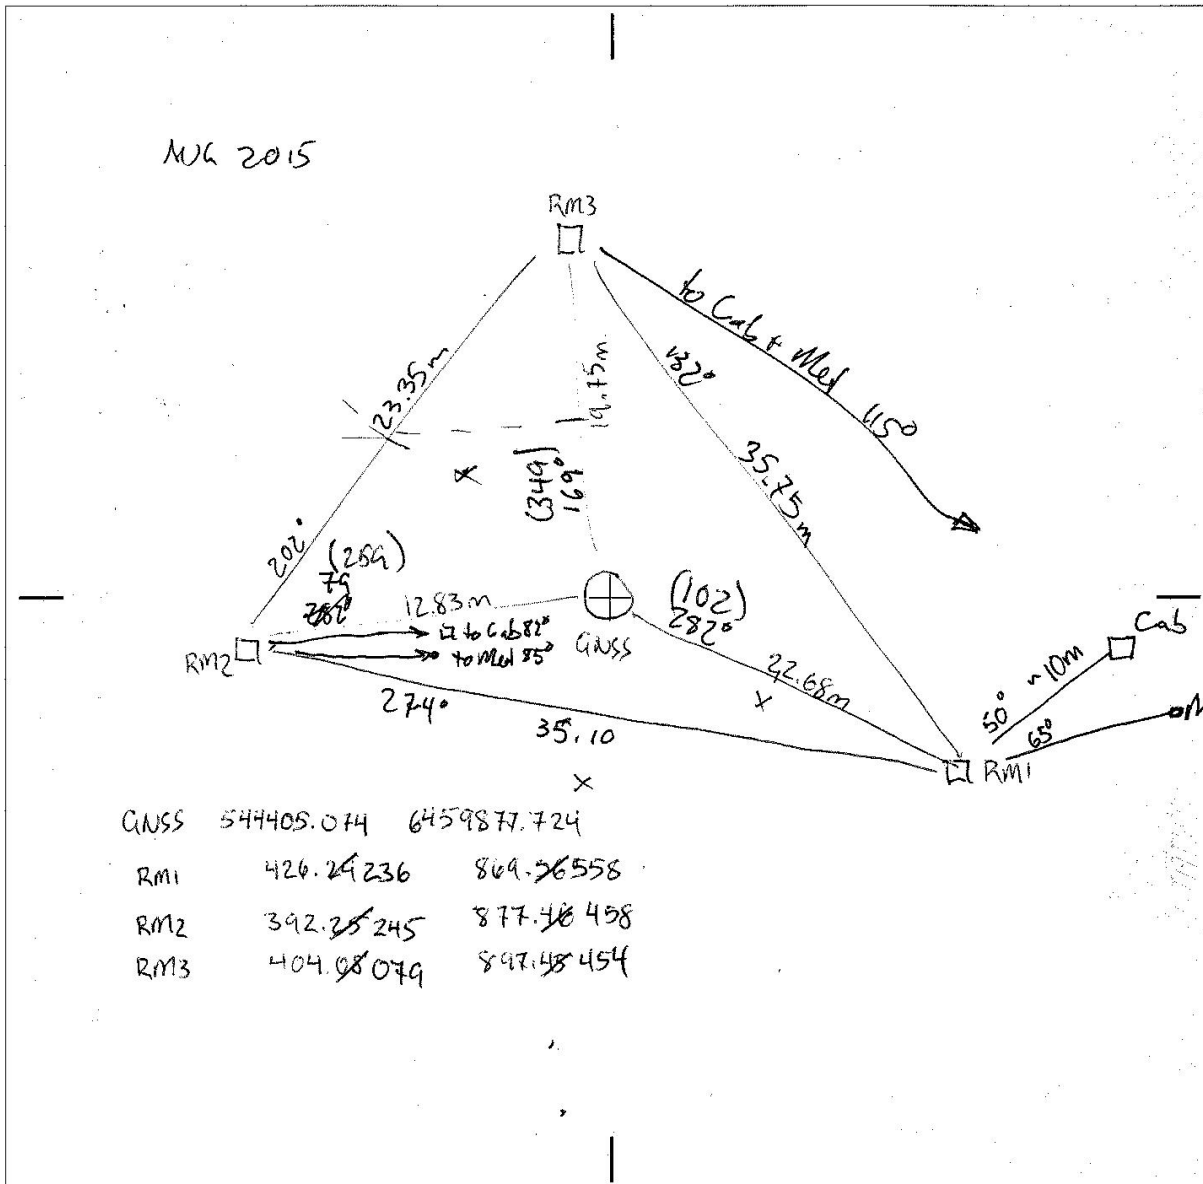

Please use black ink only

SURVEYING REGULATION			
MARK	AHD	SOURCE	DATE
HEIGHT DETERMINED BY (Specify)		- DIFF. LEVELLING	
ADOPTED MARKS		- TRIG HEIGHTING	
		- GPS	

Measurements are in metres

~~PM~~ TS 12144

~~SS~~

PM _____
 Replaces _____
 SS _____

I certify that the mark has been placed/found and numbered as detailed hereon.

Signed: _____

Name: _____

Organisation placing mark: _____

Date mark placed/found: / /

Ref: _____



LOCALITY SKETCH PLAN

RM 1, 2, 3
~~SS~~ (TS12144)

MGA E: 544405

Replaces PM/SS


MGA N: 6459877

Datum: MGA94 / MGA2020 Zone: 54 / 55 / 56 / 57 / 58

Coordinates determined by: (AUSPOS / RTK / Handheld GNSS / TRAV) Other: ADJUSTMENT

AHD Level: Mark to Ground Level: (ABOVE GROUND / BELOW GROUND)

Height determined by: (Diff Levelling / AUSPOS / RTK / Trig Heighting / Handheld GNSS) Other:

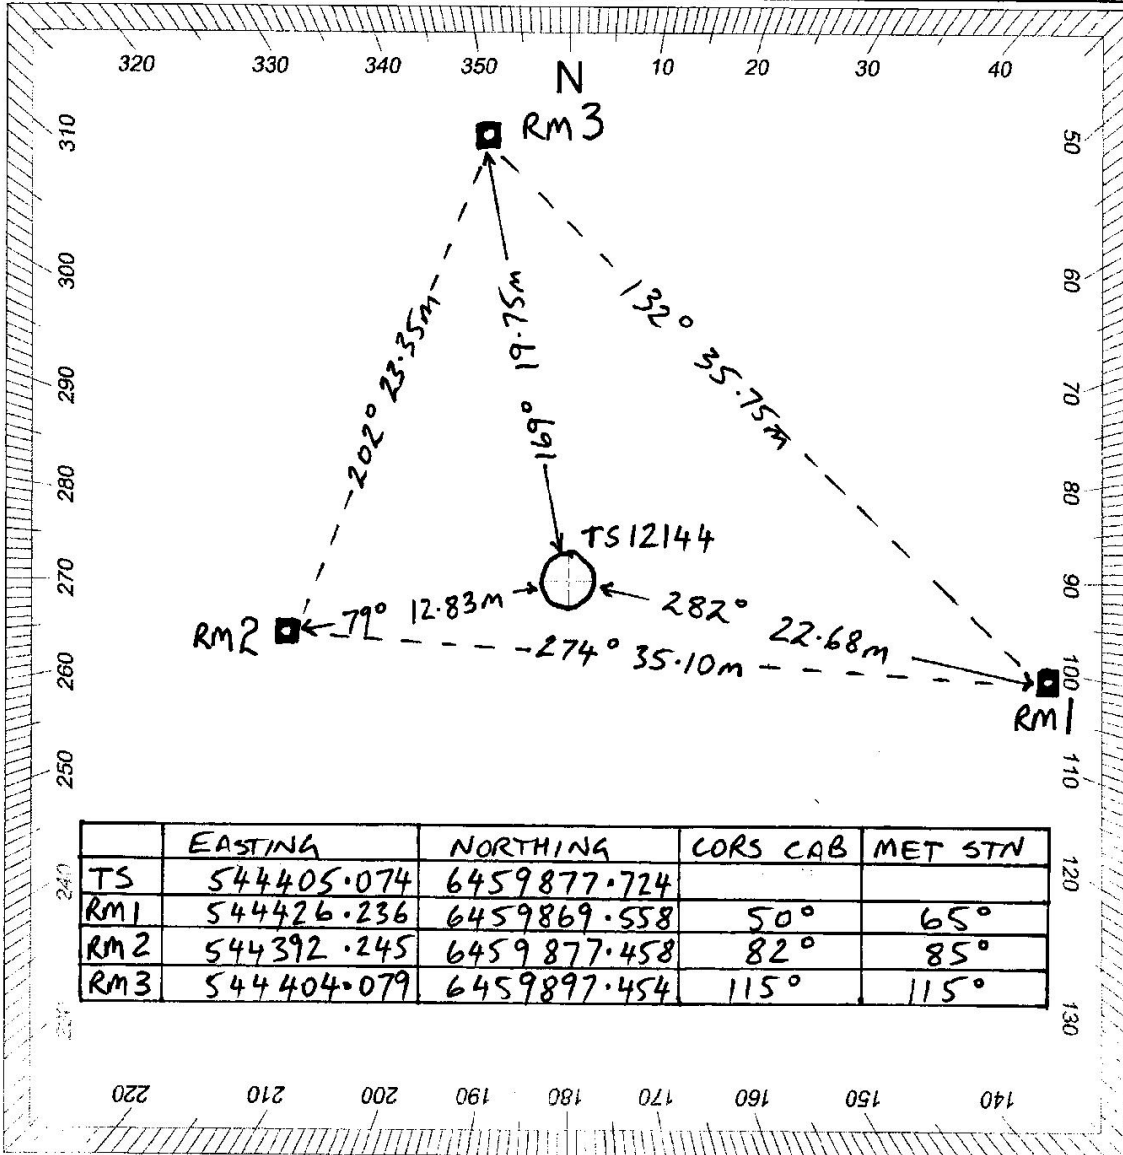

Please use black ink only
 Distances shown are in metres
 (Refer to Surveyor-General's Direction No. 2 - Preparation of Locality Sketch Plans.)

Town/Suburb/Locality: **BROKEN HILL**

Monument Description: **SS PIN IN ROCK**

I certify that the mark has been placed/found and numbered as detailed hereon.

Name of Organisation: **SPATIAL SERVICES**
 placing mark:

Date mark placed/found:

Surveyor's Ref: **NEW SKETCH**

Name:

Signed:


LOCALITY SKETCH PLAN



Local Government Area BKLN
 Town/Suburb/Locality Draft Sketch + Coords (from Adj)

Office Use - Barcode Including Number Inserted Here

Approx MGA Coordinate: Zone _____ Description of Mark _____
 E: _____
 N: _____

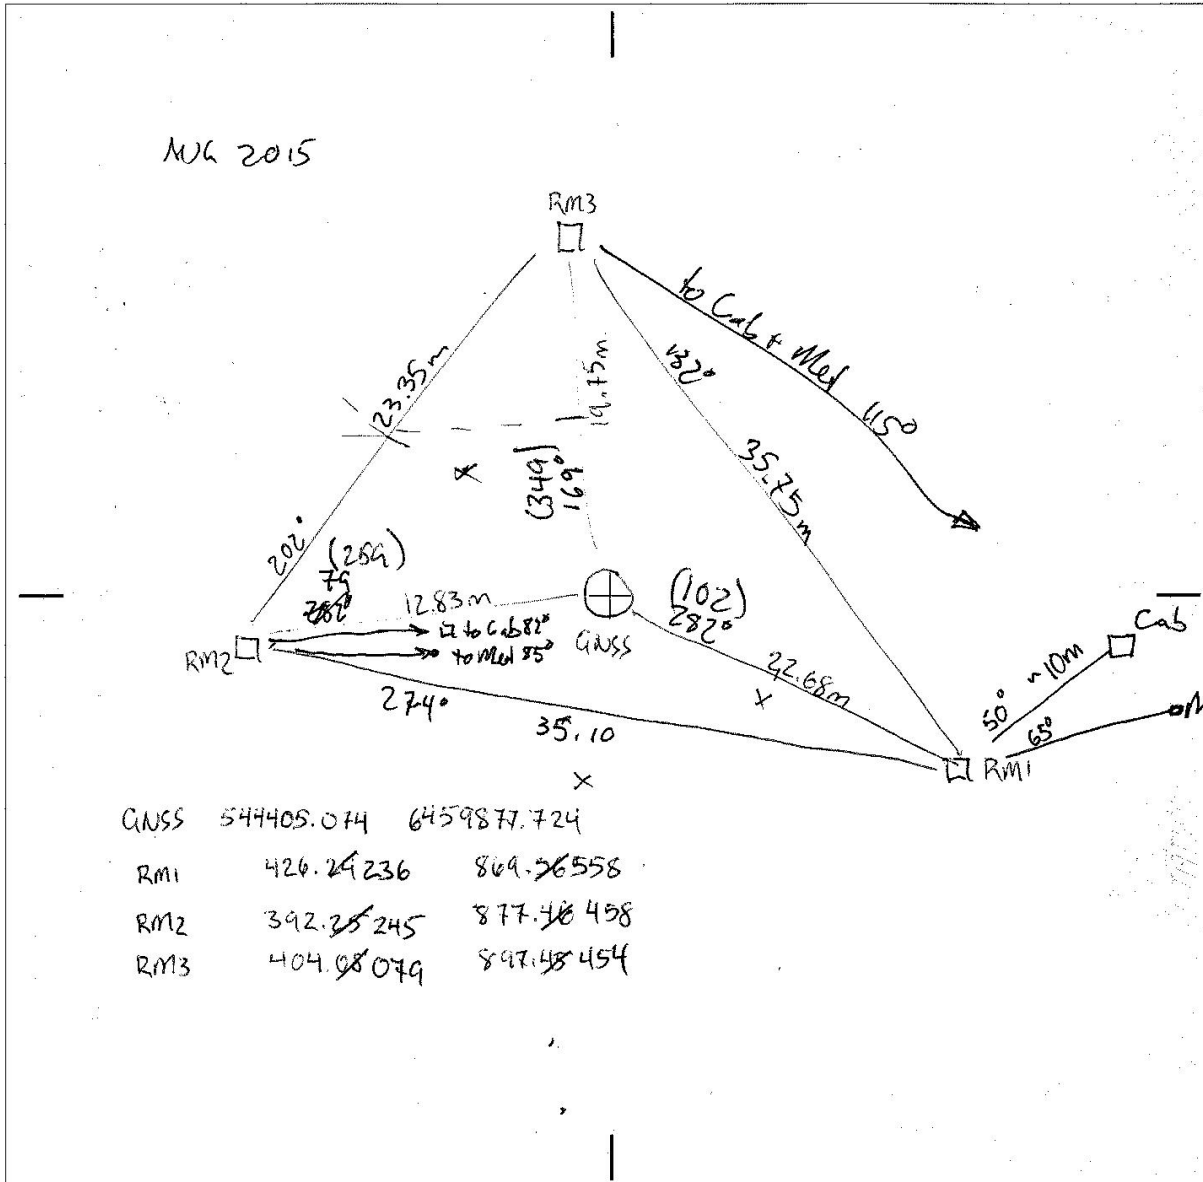

Please use black ink only

SURVEYING REGULATION			
MARK	AHD	SOURCE	DATE
HEIGHT DETERMINED BY (Specify)		- DIFF. LEVELLING	
ADOPTED MARKS		- TRIG HEIGHTING	
		- GPS	

Measurements are in metres

~~PM~~ TS 12144

~~SS~~

PM _____
 Replaces _____
 SS _____

I certify that the mark has been placed/found and numbered as detailed hereon.

Signed: _____

Name: _____

Organisation placing mark: _____

Date mark placed/found: / /

Ref: _____