

CENTRAL MAPPING AUTHORITY

GEODETIC SURVEY OF N.S.W.

GEODETIC STATION RECONNAISSANCE and MAINTENANCE REPORT

Description:

Note: Cross out word or words which do not apply

1. ~~Cleared by fence bearing..... from Trig/Mast~~
2. Mast & Vanes have been painted white & black respectively.
3. The station/pillar was unpiled/not unpiled/constructed on..... 19....., dimensions now being:
Description of mark..... should be explicit, e.g., S/Steel Pillar Plate, Steel plug, Brass plug, Bolt, G.I. Pipe
Height of mark.....m. ^{above} _{below} rock/concrete; Mark is.....m. ^{above} _{below} G.L.
Height of Top Vanes to Top Mark/Pillar plate.....m. Diameter of Vanes (vertical).....m.
Height of Cairn.....m. Diameter of Cairn.....m. Name Plate found/not found/placed.
Length of Mast.....m. (approximate if not unpiled)
4. A..... set in conc/rock has been placed/found, bearing.....° M from Mast/Plug/Pillar
5. A..... set in pond/rock has been placed/found, bearing.....° M from Mast/Plug/Pillar
6. A..... set in conc/rock has been placed/found, bearing.....° M from Mast/Plug/Pillar
7. A..... set in conc/rock has been placed/found, bearing.....° M from Mast/Plug/Pillar
8. Action required: Approval from NP & WS is required before any work can be carried out at this station

STANDPOINT:

Mark	Direction	Horiz. Distance	Height Difference	Mark	Direction	Horiz. Distance	Height Difference
			above standpt.				above standpt.
			below				below standpt.
			above standpt.				above standpt.
			below				below standpt.
Prepared by: *John R. Wallace* 28/1/82

Checked: *John R. Wallace*


SI 2733-1

STATION: *BUDTHINGEROO* No.: *1218*

MAP SHEET SCALE 1:250 000 *SYDNEY*

INSPECTED BY: *J. R. WALLACE* DATE: *8.1.82*

AUTHORITY: *C.M.A.* FIELD BOOK:

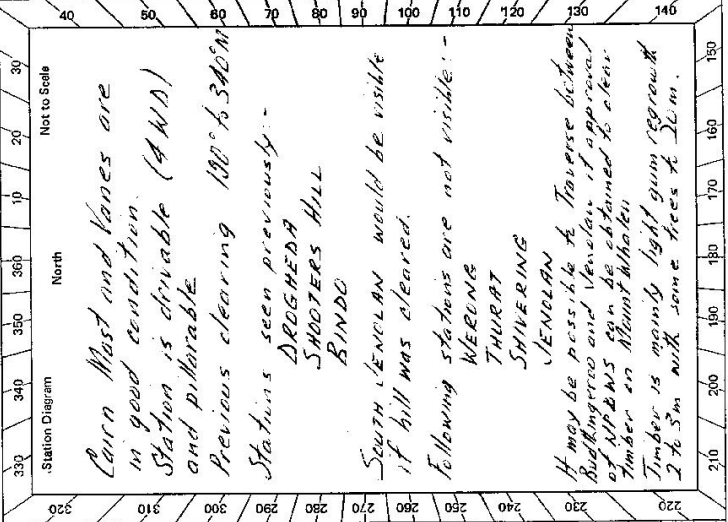

Checked


STATION **BUDTHINGEROO 1218**

Owner's Name: **N P & W S**
 Address: **Blue Mountains District**
Box #3 BLACKHEATH 2785
 Phone: **047 - 878877**

Current Occupant:
 Address:
 Phone:

ACCESS
 Access Report of **8/1/1982** was found suitable/unsuitable.

*Access track shown on Kanongra 1:25,000
 Standard Topo Map and Jenolan 1:100,000
 Standard Topo Map*

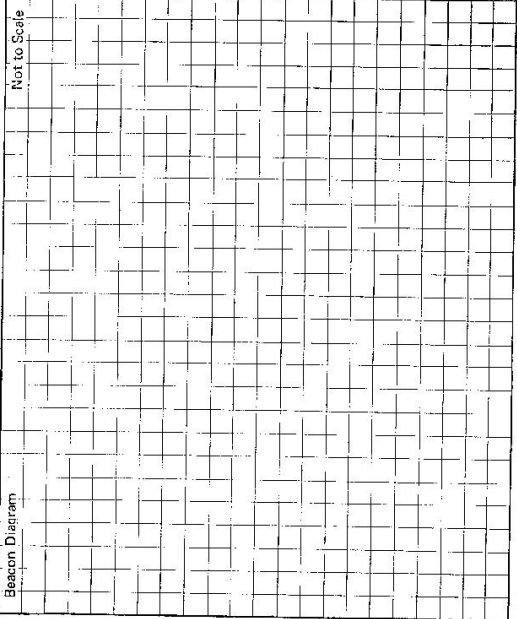

This section to be completed by officer constructing pillar.

Original station mark found/not found.

Description of mark:

Original beacon found/not found.

Description of beacon:

Height Top of Vanes to Top Mark:m.

Height of mark:m. above rock/conc.m. below G.L.

Diameter of Vanesm. Height of Cairnm.

Original Beacon has/has not been destroyed by me.

Date	Record of Station