

LOCALITY SKETCH PLAN



Local Government Area GWYDIR SHIRE

Town/Suburb/Locality NORTH STAR CORS


Office Use - Barcode Including Number Inserted Here

Approx MGA Coordinate: Zone 56

Description of Mark Reference Mark #1

E: 251128.607 by RM Survey

N: 6784286.127

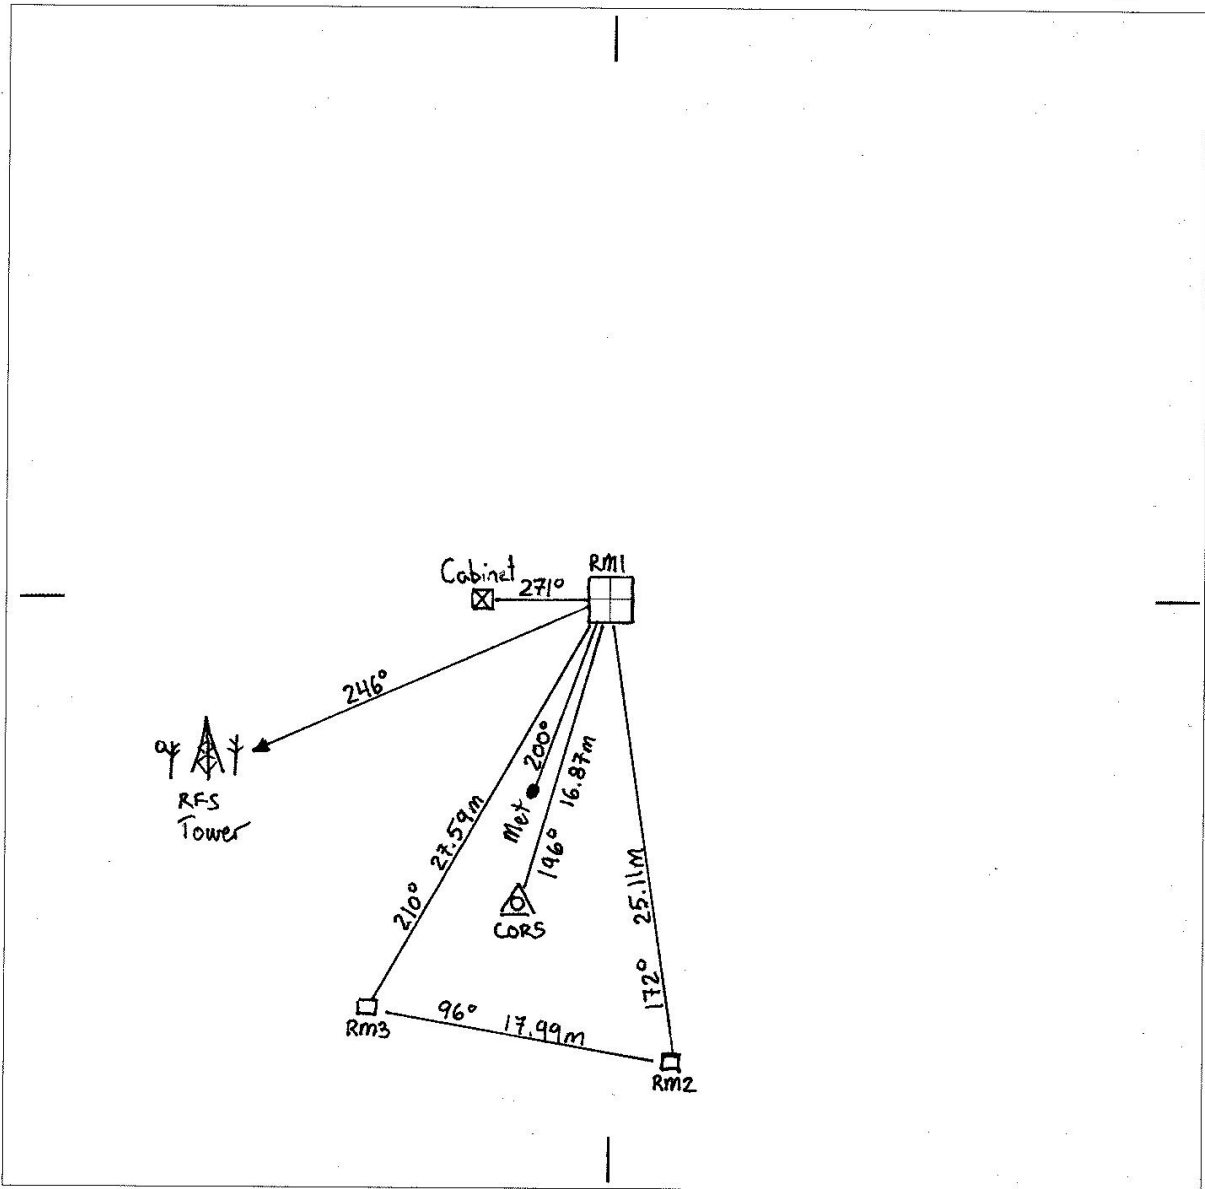

Please use black ink only

SURVEYING REGULATION			
MARK	AHD	SOURCE	DATE
HEIGHT DETERMINED BY (Specify)		- DIFF. LEVELLING - TRIG HEIGHTING - GPS	
ADOPTED MARKS			

Measurements are in metres

~~PM~~ TS 12195-1

~~SS~~

PM
Replaces

SS

I certify that the mark has been placed/ found and numbered as detailed hereon.

Signed: Tom Grinter +

Name: Joel Haasdyk

Organisation placing mark: LPMA/LPI

Date mark placed/ found: 13/12/2012

Ref: _____

LOCALITY SKETCH PLAN




Local Government Area GWYDIR SHIRE

Town/Suburb/Locality NORTH STAR CORNS

Office Use - Barcode Including Number Inserted Here

Approx MGA Coordinate: Zone 56
 E: 251126.844 by RM Survey
 N: 6784261.068

Description of Mark Reference Mark #2

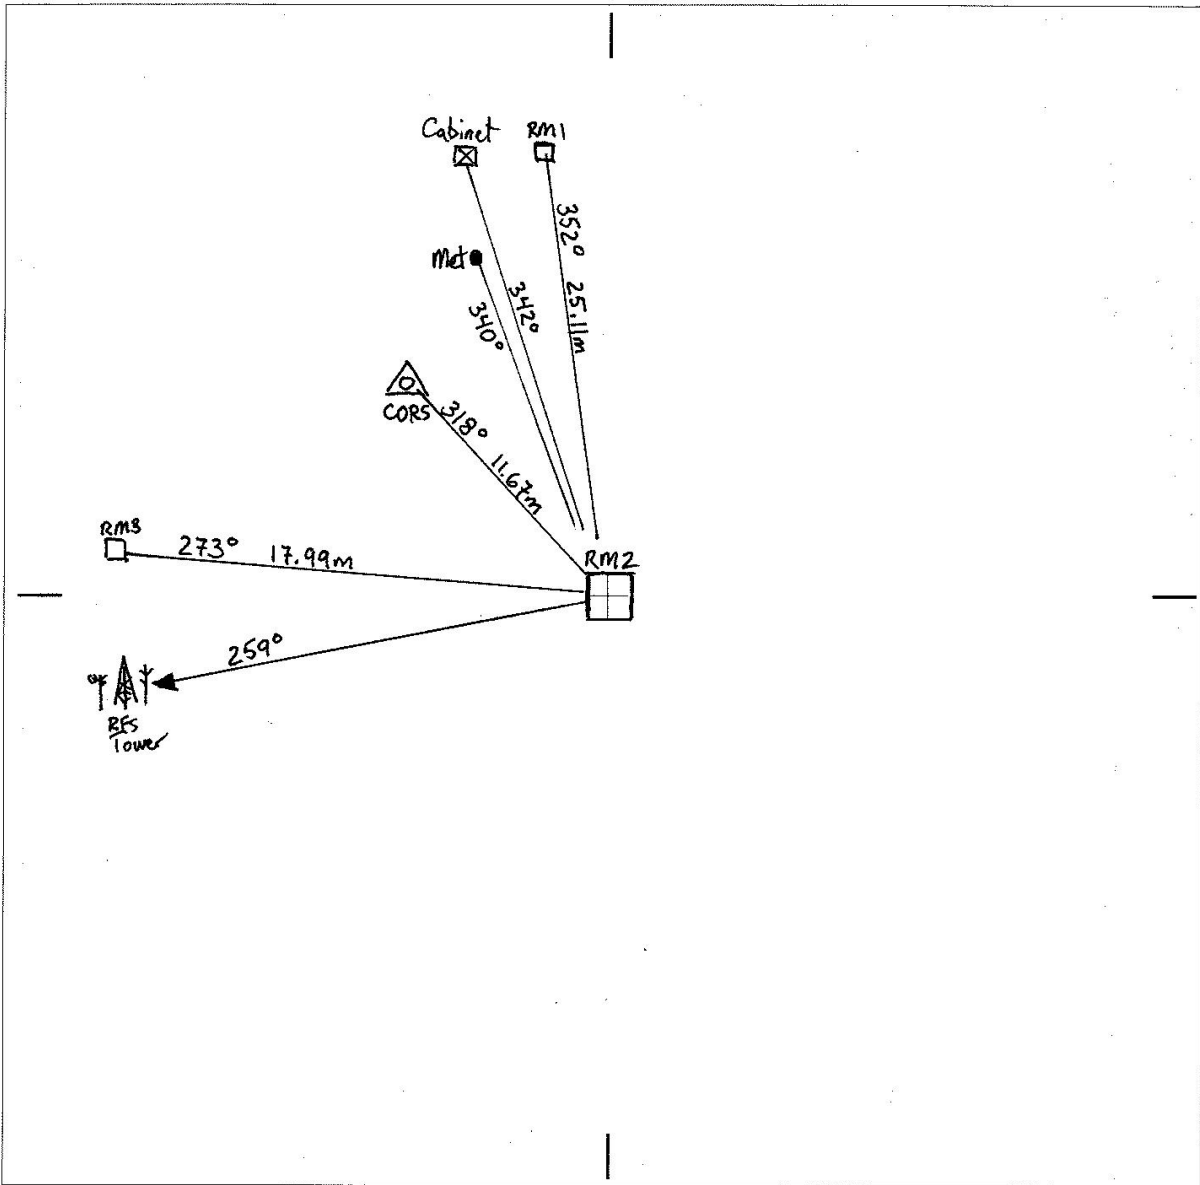

Please use black ink only

SURVEYING REGULATION			
MARK	AHD	SOURCE	DATE
HEIGHT DETERMINED BY (Specify)		- DIFF. LEVELLING - TRIG HEIGHTING	
ADOPTED MARKS		- GPS	

Measurements are in metres

~~PM~~ TS 12195-2

~~SS~~

PM

Replaces

SS

I certify that the mark has been placed/found and numbered as detailed hereon.

Signed: Tom Ginter +

Name: Joel Haacduk

Organisation placing mark: LPMA/LPI

Date mark placed/found: 13/12/2012

Ref:

LOCALITY SKETCH PLAN



Local Government Area GWYDIR SHIRE

Town/Suburb/Locality NORTH STAR CORS


Office Use - Barcode Including Number Inserted Here

Approx MGA Coordinate: Zone 56

Description of Mark Reference Mark #3

E: 251109.580 by RM Survey

N: 6784266.136

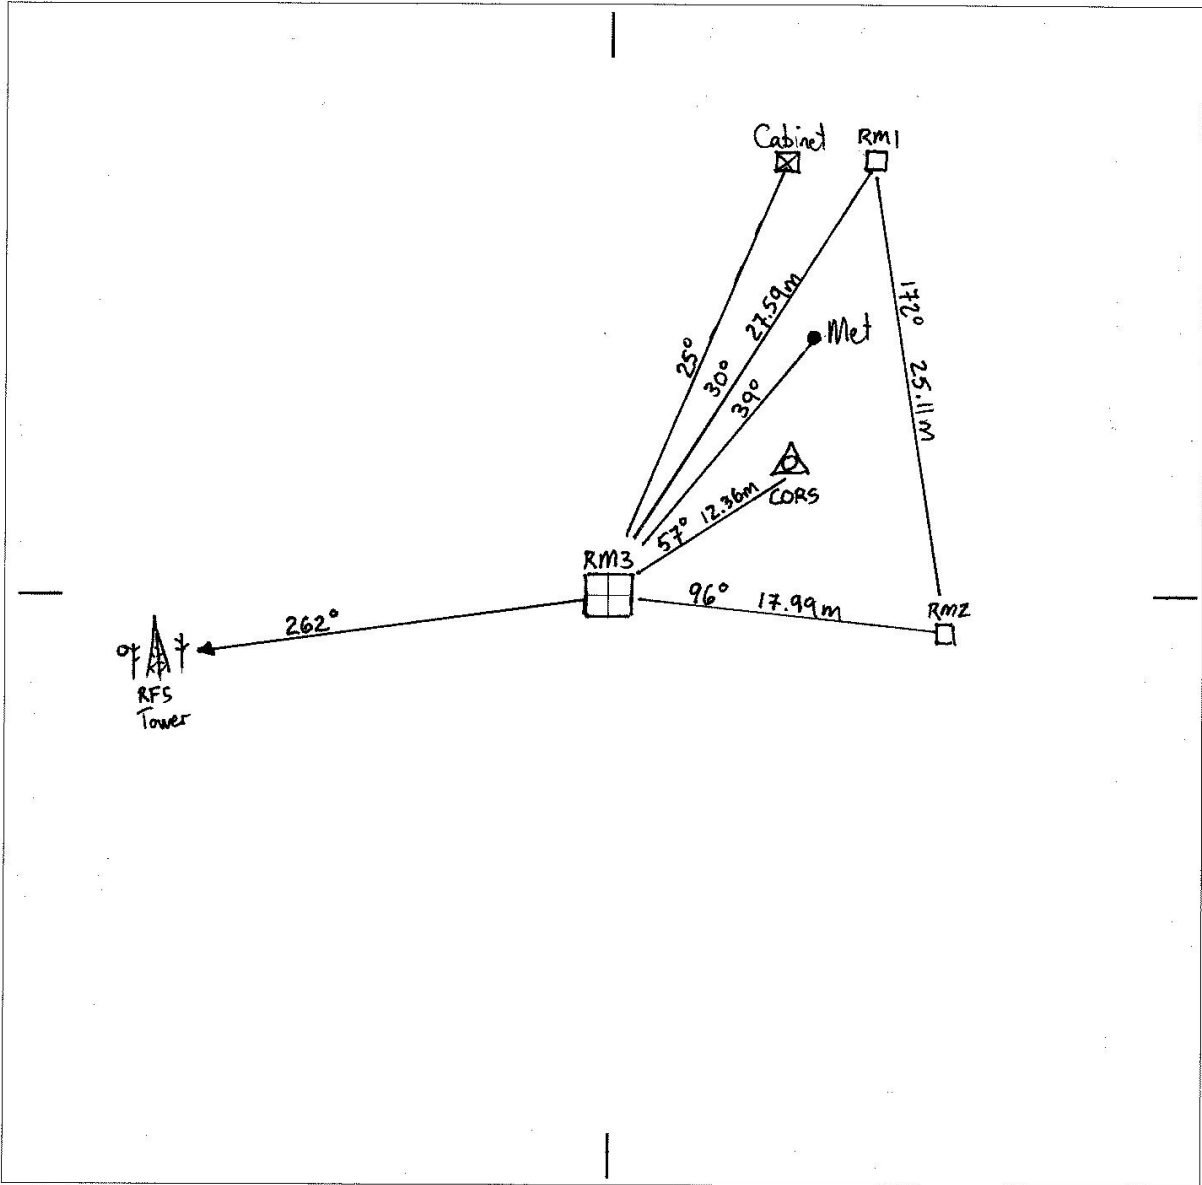

Please use black ink only

SURVEYING REGULATION			
MARK	AHD	SOURCE	DATE
HEIGHT DETERMINED BY (Specify)		- DIFF. LEVELLING	
		- TRIG HEIGHTING	
ADOPTED MARKS		- GPS	

Measurements are in metres

~~PM~~ TS 12195-3

~~SS~~

PM
Replaces
SS

I certify that the mark has been placed/found and numbered as detailed hereon.

Signed: Tom Grinter +

Name: Joel Haasdyk

Organisation placing mark: LPMA/LPI

Date mark placed/found: 13/12/2012

Ref: