

# LOCALITY SKETCH PLAN



Local Government Area NBRK

Town/Suburb/Locality Draft sketch + Coords (from 16j)


Office Use - Barcode Including Number Inserted Here

Approx MGA Coordinate: Zone \_\_\_\_\_

Description of Mark \_\_\_\_\_

E: \_\_\_\_\_

N: \_\_\_\_\_

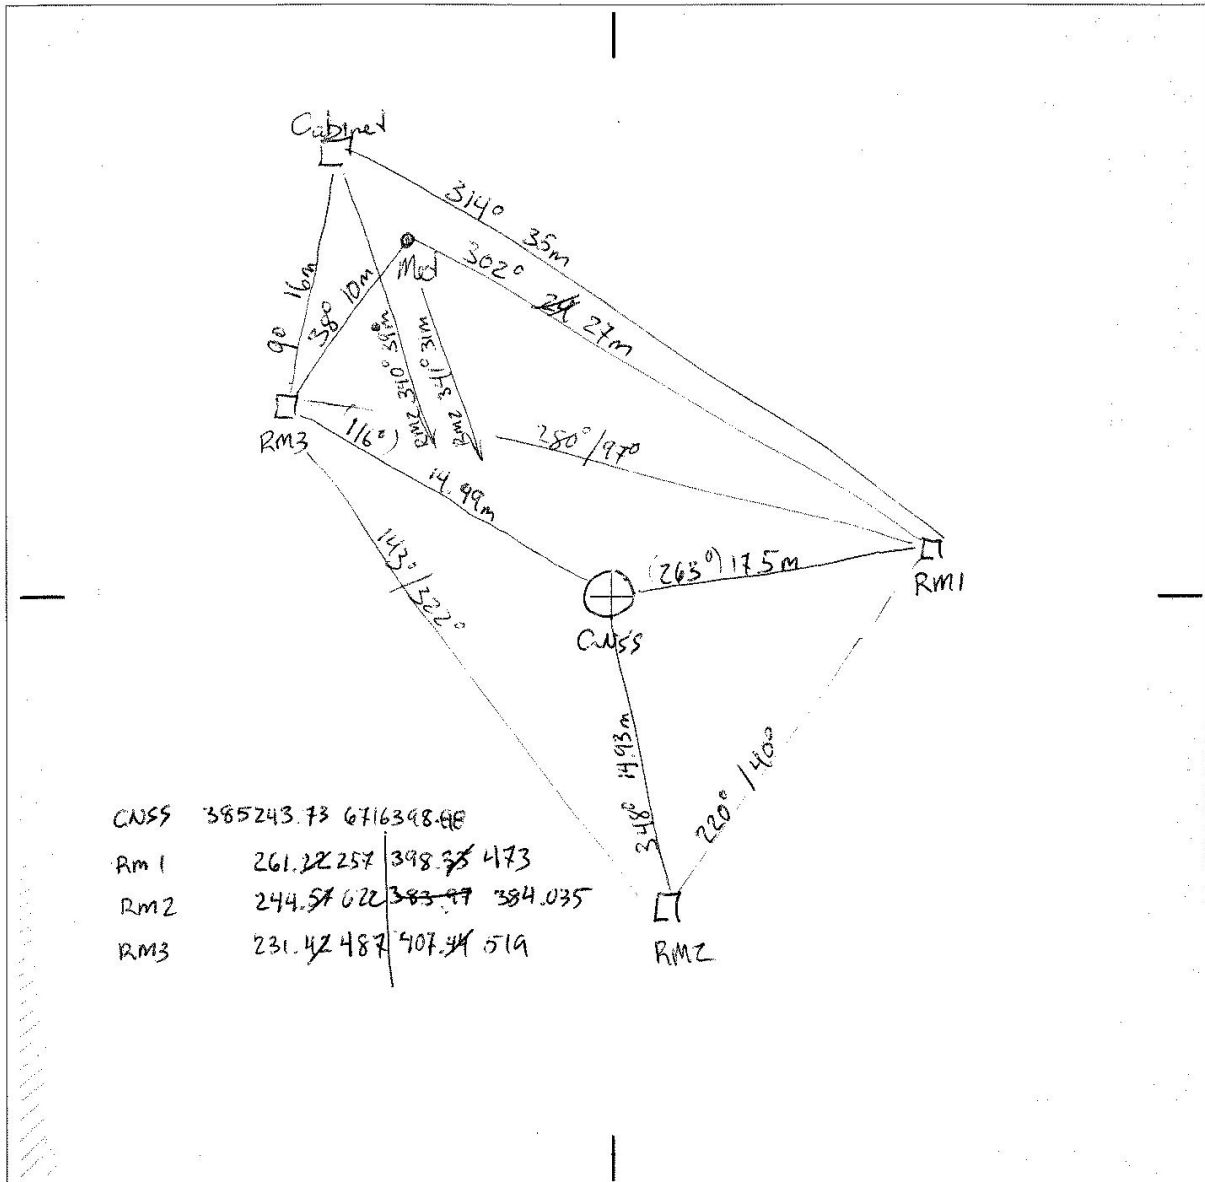

Please use black ink only

SURVEYING REGULATION			
MARK	AHD	SOURCE	DATE
HEIGHT DETERMINED BY - DIFF. LEVELLING (Specify)			
- TRIG HEIGHTING			
ADOPTED MARKS - GPS			

Measurements are in metres

~~PM~~ TS 12207

~~SS~~

PM \_\_\_\_\_  
Replaces

SS \_\_\_\_\_

I certify that the mark has been placed/found and numbered as detailed hereon.

Signed: \_\_\_\_\_

Name: \_\_\_\_\_

Organisation placing mark: \_\_\_\_\_

Date mark placed/found: / /

Ref: \_\_\_\_\_



# LOCALITY SKETCH PLAN

RM 1, 2, 3  
~~SS~~ (TS 12207)

MGA E: 385243

Replaces PM/SS

MGA N: 6716398

Datum: MGA94 / ~~MGA2020~~

Zone: ~~54~~ / 55 / 56 / 57 / 58

Coordinates determined by: (AUSPOS / RTK / Handheld GNSS / TRAV)


Other: ADJUSTMENT

AHD Level:

Mark to Ground Level:

( ABOVE GROUND  
 BELOW GROUND )

Height determined by: (Diff Levelling / AUSPOS / RTK / Trig Heighting / Handheld GNSS) Other:

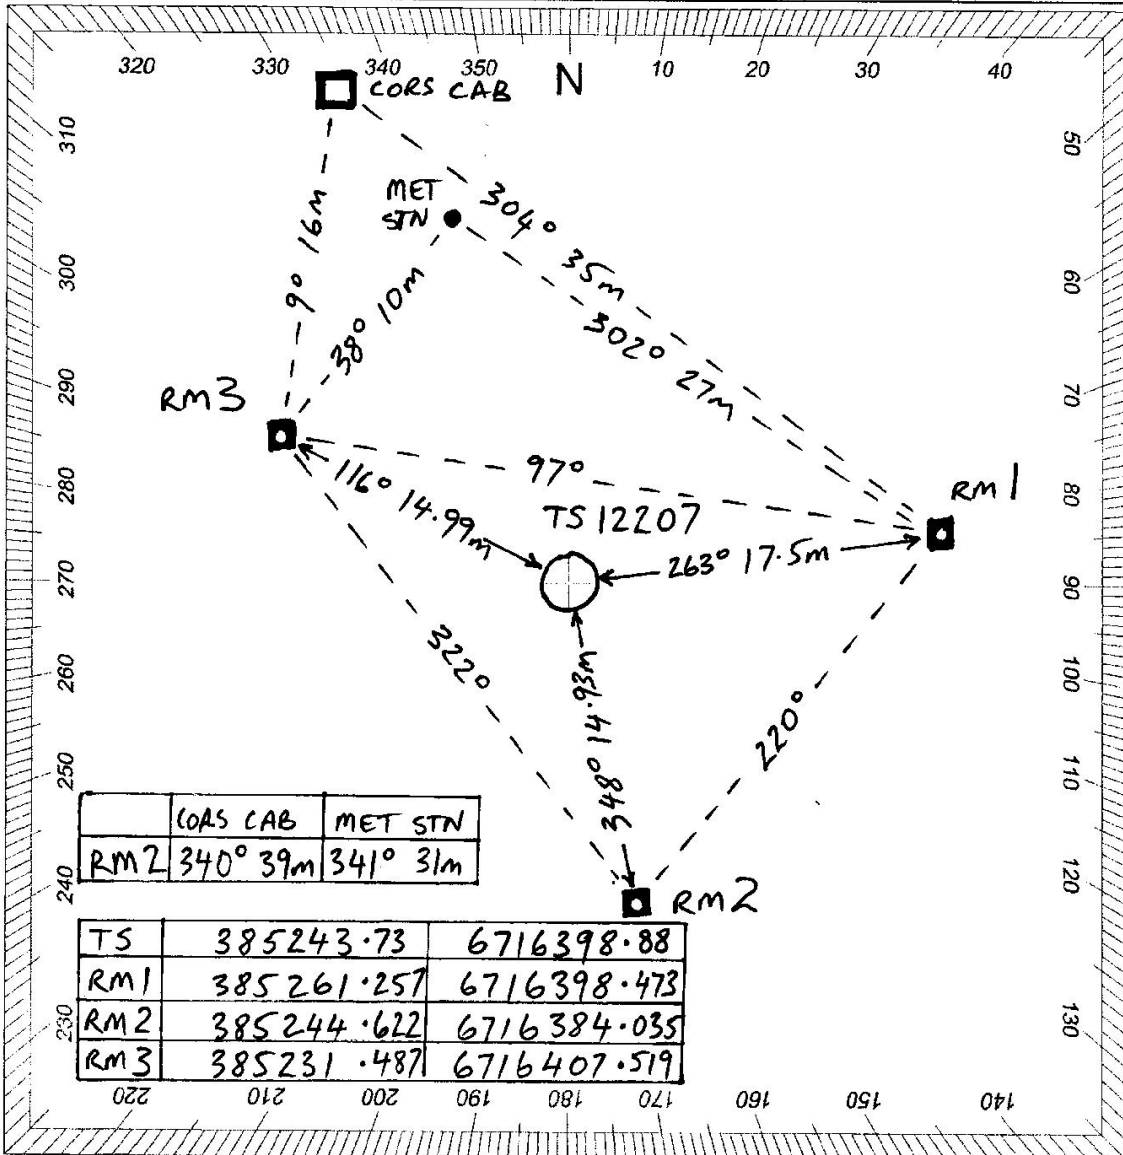

Please use black ink only  
 Distances shown are in metres  
 (Refer to Surveyor-General's Direction No. 2 - Preparation of Locality Sketch Plans.)

Town/Suburb/Locality: NORTH BOURKE

Monument Description: SS PIN IN ROCK

I certify that the mark has been placed/found and numbered as detailed hereon.

Name of Organisation placing mark: SPATIAL SERVICES

Date mark placed/found:

Surveyor's Ref: NEW SKETCH

Name:

Signed:

# LOCALITY SKETCH PLAN



Local Government Area NBRK

Town/Suburb/Locality Draft sketch + Coords (from 16)


Office Use - Barcode Including Number Inserted Here

Approx MGA Coordinate: Zone

Description of Mark

E:

N:

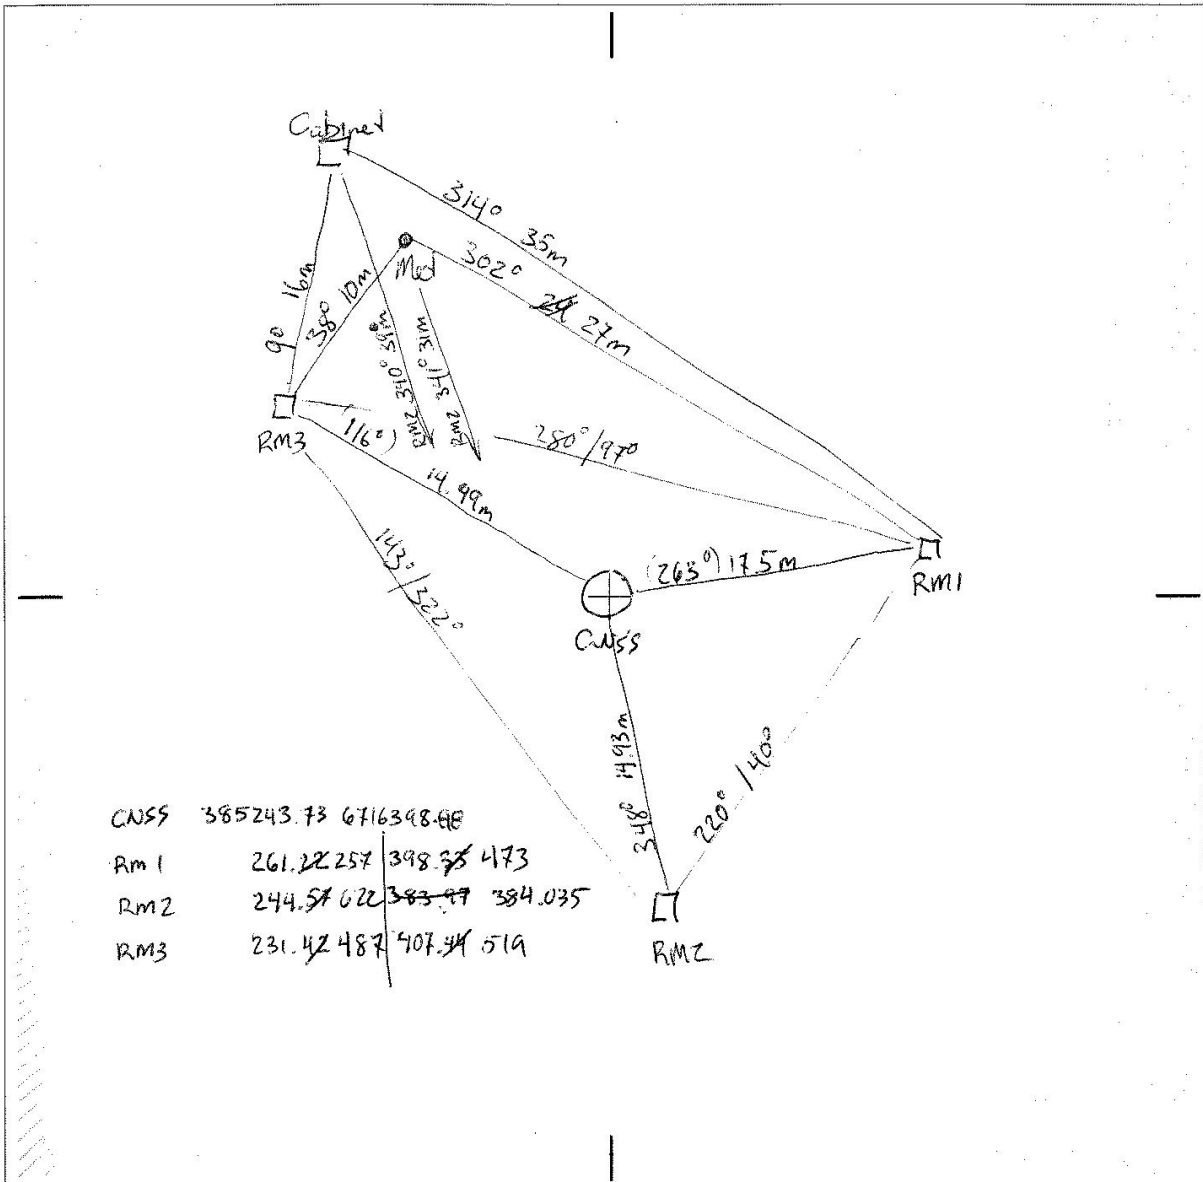

Please use black ink only

SURVEYING REGULATION			
MARK	AHD	SOURCE	DATE
HEIGHT DETERMINED BY - DIFF. LEVELLING (Specify) - TRIG HEIGHTING			
ADOPTED MARKS - GPS			

Measurements are in metres

~~PM~~ TS 12207

~~SS~~

PM

Replaces

SS

I certify that the mark has been placed/found and numbered as detailed hereon.

Signed: \_\_\_\_\_

Name: \_\_\_\_\_

Organisation placing mark: \_\_\_\_\_

Date mark placed/found: / /

Ref: \_\_\_\_\_