

CENTRAL MAPPING AUTHORITY

GEODETIC SURVEY OF N.S.W.

GEODETIC STATION RECONNAISSANCE and MAINTENANCE REPORT

STATION: **BUGONG** No.: **1222**


MAP SHEET SCALE 1:250 000 **Wollongong**

INSPECTED BY: **A. Sivertsen** DATE: **9-1-79**

AUTHORITY: **CMA** FIELD BOOK: **1723**

Description: *Note: Cross out word or words which do not apply*

1. Cleared by lances bearing **Timbered** <sup>360</sup> ~~while~~ from Trig. Mast
2. Mast & Vanes have been painted white & black respectively. by **NMS-438**
3. The station/pillar was unpiled/~~re-erected~~/constructed on <sup>19</sup> dimensions now being: Description of mark **Brass Trig. Pillar** should be explicit, e.g., S/Steel Pillar Plate, Steel plug, Brass plug, Bolt, G.I. Pipe  
Height of mark <sup>above</sup> ~~below~~ rock/concrete; Mark is <sup>above</sup> ~~below~~ G.L.
- Height of Top Vanes to Top Mark ~~at~~ <sup>4.135</sup> m. Diameter of Vanes (vertical) <sup>0.61</sup> m.
- Height of Cairn <sup>NA</sup> m. Diameter of Cairn <sup>NA</sup> m. Name Plate ~~found~~/not found/~~placed~~.
- Length of Mast <sup>NA</sup> m. (approximate if not unpiled)
4. A. <sup>set in conc/rock</sup> has been placed/~~found~~, bearing <sup>NA</sup> ° M from Mast/Plug/Pillar
5. A. <sup>set in conc/rock</sup> has been placed/~~found~~, bearing <sup>NA</sup> ° M from Mast/Plug/Pillar
6. A. <sup>set in conc/rock</sup> has been placed/~~found~~, bearing <sup>NA</sup> ° M from Mast/Plug/Pillar
7. A. <sup>set in conc/rock</sup> has been placed/~~found~~, bearing <sup>NA</sup> ° M from Mast/Plug/Pillar
8. Action required: **BARRIER** ~~Sta. Top.~~

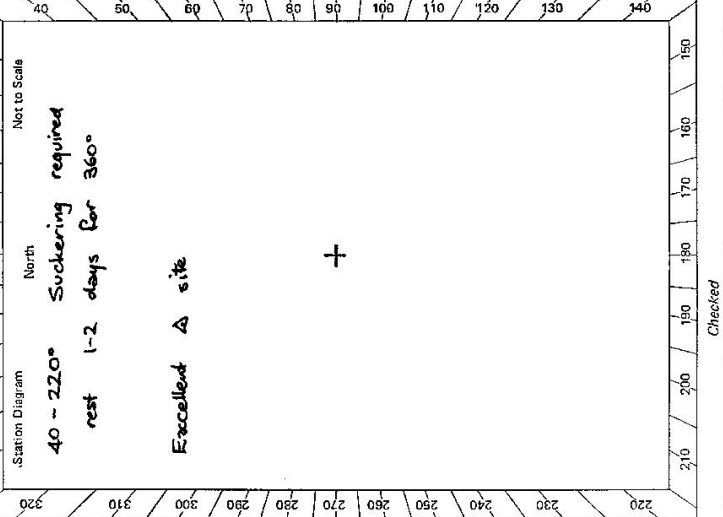

STANDPOINT:			
Mark	Direction	Horiz. Distance	Height Difference
			above standpt.
			below
			above standpt.
			below
Prepared by: *[Signature]* 23-1 Checked: *[Signature]* Noted on U.T.M. Card


Checked

STATION **BUGONG** 1222

Owner's Name: .....  
 Address: .....  
 Phone: .....  
 Current Occupant: .....  
 Address: .....  
 Phone: .....

ACCESS  
 Access Report of 9.11.1978 was found suitable/unsuitable.

**AND**  
 KANGAROO VALLEY P.O. towards MOSS VALE  
 0.7 Turn L towards BUGONG rd MT. SCANZI  
 5.5 Turn L towards MT. SCANZI  
 7.8 At top of BUGONG PASS. Take track to R  
 Iron Gate.  
 8.4 Wire Gate  
 9.9 Pass track 4 yards on L  
 10.4 Wire Gate  
 10.5 Pass track on R  
 11.0 Creek  
 11.2 Wire Gate  
 11.5 Take centre track up spur  
 End of track. 10 min climb

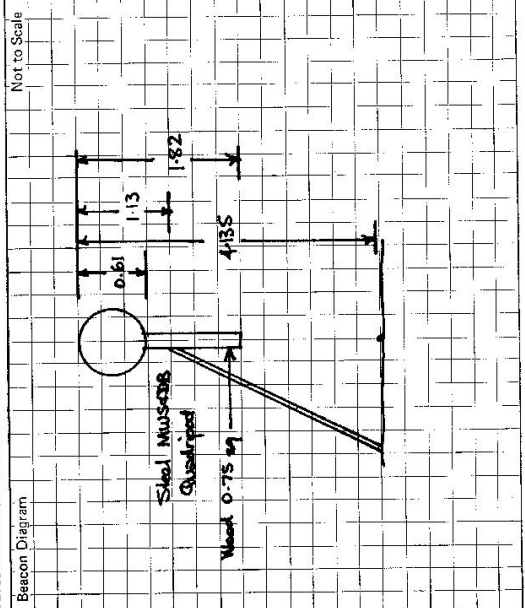

This section to be completed by officer constructing pillar.

Original station mark found/not found.

Description of mark: .....

Original beacon found/not found.

Description of beacon: .....

Height Top of Vanes to Top Mark: .....m.

Height of mark: .....m. above G.L. below rock/cone

Diameter of Vanes: .....m. Height of Gain: .....m.

Original Beacon has/has not been destroyed by me.

Date	Record of Station

CENTRAL MAPPING AUTHORITY

GEODETIC SURVEY OF N.S.W.

GEODETIC STATION RECONNAISSANCE and MAINTENANCE REPORT

Description:

Note: Cross out word or words which do not apply

1. Cleared by fence-bearing... COMPLETELY BY SURVEYORS (1-2 DAY CLEARANCE 3000' from Trig. Mast)
2. Mast & Vanes have been painted white & black respectively
3. The station/pillar was unpiled/not unpiled/constructed on..... 19....., dimensions now being:  
 Description of mark..... should be explicit, e.g., S/Steel Pillar Plate, Steel plug, Brass plug, Bolt, G.I. Pipe  
 Height of mark.....m. above rock/concrete; Mark is.....m. above G.L.  
 Height of Top Vanes to Top Mark/Pillar plate .....m. Diameter of Vanes (vertical).....m.  
 Height of Cairn.....m. Diameter of Cairn.....m. Name Plate found/not found/.....  
 Length of Mast.....m. (approximate if not unpiled)
4. A..... set in conc/rock has been placed/found, bearing.....°M from Mast/Plug/Pillar
5. A..... set in conc/rock has been placed/found, bearing.....°M from Mast/Plug/Pillar
6. A..... set in conc/rock has been placed/found, bearing.....°M from Mast/Plug/Pillar
7. A..... set in conc/rock has been placed/found, bearing.....°M from Mast/Plug/Pillar
8. Action required... **SUITABLE FOR ROOFTOP PILLAR - EXCELLENT TRIG SITE - 360° VISIBILITY WITH MODERATE CLEARING REQUIRED**

STANDPOINT:


Mark	Direction	Horiz. Distance	Height Difference	Mark	Direction	Horiz. Distance	Height Difference
			above standpt				above standpt
			below				below
			above standpt				above standpt
			below				below
Prepared by: *Atch. 5/4/81*

Checked:

Noted on U.T.M. Card

Checked: *W. Pines 18/6/86*

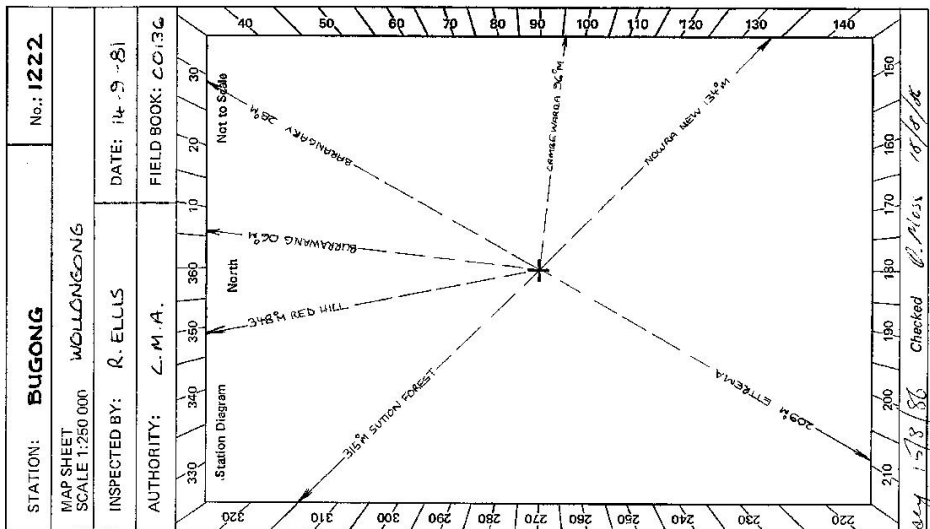

GS 24

STATION **BUGONG** 1222

Owner's Name: PETER GERSEY  
 Address: "BUGONG GAP"  
 Phone: (044) 65 1143 (Before 0800)  
 is best.

Current Occupant:  
 Address:  
 Phone:

ACCESS

Access Report of 11/1/1981 was found suitable/unsuitable.

KM FEATURE

0.0 KANGAROO VALLEY P.O. ~ HEAD TOWARDS MCOS VALE  
 0.7 TURN LEFT TOWARDS BUGONG & MI SCANZI  
 5.57 TURN LEFT TOWARDS MI SCANZI  
 7.96 AT TOP OF BUGONG PASS TAKE TRACK TO RIGHT.  
 8.07 PASS TRACK ON RIGHT.  
 8.64 WIRE GATE.  
 10.10 PASS TRACK AND YARDS ON LEFT.  
 10.55 WIRE GATEWAY.  
 10.69 PASS TRACK ON RIGHT.  
 10.84 CREEK -- TAKE FAINT TRACK TO RIGHT.  
 11.17 WIRE GATE -- MAKE WAY UP SPUR -- PAINT TRACK.  
 11.78 PARK TRACK ~ 10-15 MIN STEEP WALK

NOTE: OWNER STATED HE WAS THINKING OF PUTTING A TRACK UP THE NORTHEAST SIDE OF THE MOUNTAIN. THIS COULD SAVE WALKING TIME, AND ALLOW VEHICLES TO BE PARKED QUITE CLOSE TO TRIG.

Beacon Diagram	Not to Scale
<p>QUARRIED IN GOOD CONDITION                  MOSTLY VAPES IN REASONABLE CONDITION.</p> <p>* NOTE * SOLID ROCK SLAB SUITABLE FOR ADOPTED PILLAR</p>	

This section to be completed by officer constructing pillar.

Original station mark found/not found.

Description of mark: .....

Original beacon found/not found.

Description of beacon: .....

Height: Top of Vane to Top Mark .....m.

Height of mark: .....m. above G.L. below

Diameter of Vapes .....m. Height of Cairn .....m.

Original Beacon has/has not been destroyed by me.

Date	Record of Station