

GEODETTIC SURVEY OF N.S.W.

CENTRAL MAPPING AUTHORITY

GEODETTIC STATION RECONNAISSANCE and MAINTENANCE REPORT

Description:

1. Cleared by lanes bearing.....

Station: BULEE G.S. No.: 1228

MAP SHEET SCALE 1:250 000 HOLLINGSWORTH

2. Mast & Vanes have been painted white & black respectively.

INSPECTED BY: M.L. HOLLISON DATE: 25/10/78

AUTHORITY: C.M.A. FIELD BOOK: 1710

3. The station/pillar was unpiled/not unpiled/constructed on.....

Station Diagram

Description of mark.....should be explicit, e.g., S/Steel Pillar Plate, Steel plug, Brass plug, Bolt, G.I. Pipe

Trig. set in fair condition and mast or vanes. No other mark found. 2 to 3 days clearing for 360° vision.

Height of mark.....m. <sup>above</sup>/<sub>below</sub> rock/concrete; Mark is.....m. <sup>above</sup>/<sub>below</sub> G.L.

Not to Scale

Height of Top Vanes to Top Mark/Pillar plate.....m. 0.80 top Diameter of Vanes (vertical).....m.

North

Height of Cairn.....m. Diameter of Cairn.....m. Name Plate found/not found/pileed.....

+

Length of Mast.....m. (approximate if not unpiled)

220 230 240 250 260 270 280 290 300 310 320

4. A.....set in conc/rock has been placed/found, bearing.....°M from Mast/Plug/Pillar

330 340 350 360 370 380 390 400

5. A.....set in conc/rock has been placed/found, bearing.....°M from Mast/Plug/Pillar

210 220 230 240 250 260 270 280 290 300 310 320

6. A.....set in conc/rock has been placed/found, bearing.....°M from Mast/Plug/Pillar

180 190 200 210 220 230 240 250 260 270 280 290 300 310 320

7. A.....set in conc/rock has been placed/found, bearing.....°M from Mast/Plug/Pillar

150 160 170 180 190 200 210 220 230 240 250 260 270 280 290 300 310 320

8. Action required:.....

120 130 140 150 160 170 180 190 200 210 220 230 240 250 260 270 280 290 300 310 320

STANDPOINT:

Mark	Direction	Horiz. Distance	Height Difference	Mark	Direction	Horiz. Distance	Height Difference
			above standpt.				above standpt.
			below standpt.				below standpt.
			above standpt.				above standpt.
			below standpt.				below standpt.
Prepared by: [Signature] 15/11/78

Checked: [Signature]

Noted on U.T.M. Card

St 2733-2 D. West, Government Printer


STATION BULEE G.S. 1228

Owner's Name: .....  
 Address: .....  
 Phone: .....  
 Current Occupant: .....  
 Address: .....  
 Phone: .....

**ACCESS**

Access Report of 25/10/78 was found suitable/unsuitable.

*Direction*  
 0.00 *Norvegia Rd. Head towards Nourse*  
 9.50 *Turn left Sign Towards*  
 10.30 *Take right hand fork*  
 14.80 *Back Street Trig abt 5mins easy walk uphill on your right.*

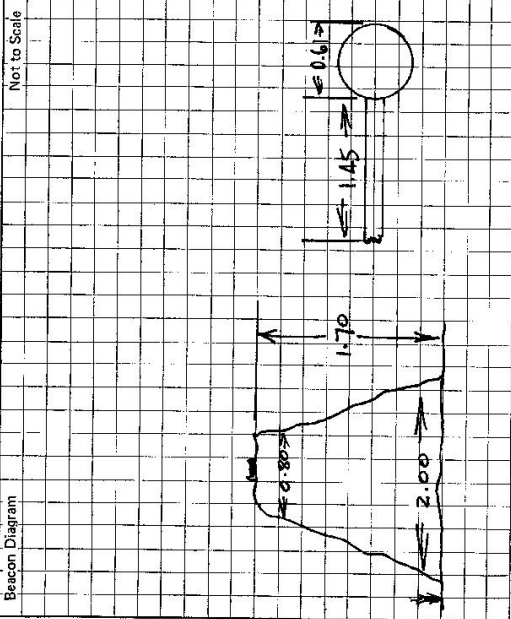

This section to be completed by officer constructing pillar.

Original station mark found/not found.

Description of mark: .....

Original beacon found/not found.

Description of beacon: .....

Height Top of Vanes to Top Mark: .....m.

Height of mark: .....m. above G.L.  
 below rock/conc. ....m. below

Diameter of Vanes .....m. Height of Cairn .....m.

Original Beacon has/has not been destroyed by me.

Date	Record of Station

CENTRAL MAPPING AUTHORITY

GEODETIC STATION RECONNAISSANCE and MAINTENANCE REPORT

STATION: **BULEE** No: **1228**

MAP SHEET SCALE 1:250 000 Wollongong

INSPECTED BY: **J. Judge** DATE: **30-7-80**

AUTHORITY: **C.M.A.** FIELD BOOK: **C.0135**

Description: *Note: Cross out word or words which do not apply*  
 1. Cleared by lanes bearing..... from Trig. Mast

2. Mast & Vanes have been painted white & black respectively.

3. The station/pillar was unpainted/not unpainted/constructed on **30-7-1981**, dimensions now being:

Description of mark..... should be explicit, e.g., S/Steel Pillar Plate, Steel plug, Brass plug, Boll, G.I. Pipe

Height of mark.....m. above/below G.L. Mark is.....m. above/below

Height of Top Vanes to Top Mark/Pillar plate.....m. Diameter of Vanes (vertical).....m.

Height of Cairn.....m. Diameter of Cairn.....m. Name Plate found/not found/placed.

Length of Mast.....m. (approximate if not unpiled)

4. A..... set in conc/rock has been placed/found, bearing.....°M from Mast/Plug/Pillar

5. A..... set in conc/rock has been placed/found, bearing.....°M from Mast/Plug/Pillar

6. A..... set in conc/rock has been placed/found, bearing.....°M from Mast/Plug/Pillar

7. A..... set in conc/rock has been placed/found, bearing.....°M from Mast/Plug/Pillar


8. Action required: **RETAIN FOR MAPPING PURPOSES ONLY**

STANDPOINT:				STANDPOINT:			
Mark	Direction	Horiz. Distance	Height Difference	Mark	Direction	Horiz. Distance	Height Difference
			above standpt.				above standpt.
			below				below
			above standpt.				above standpt.
			below				below
Prepared by: *W. 21/9/80* Checked: *W. 18/10/86*

St 2793-1

*Noted on U.T.M. Card*

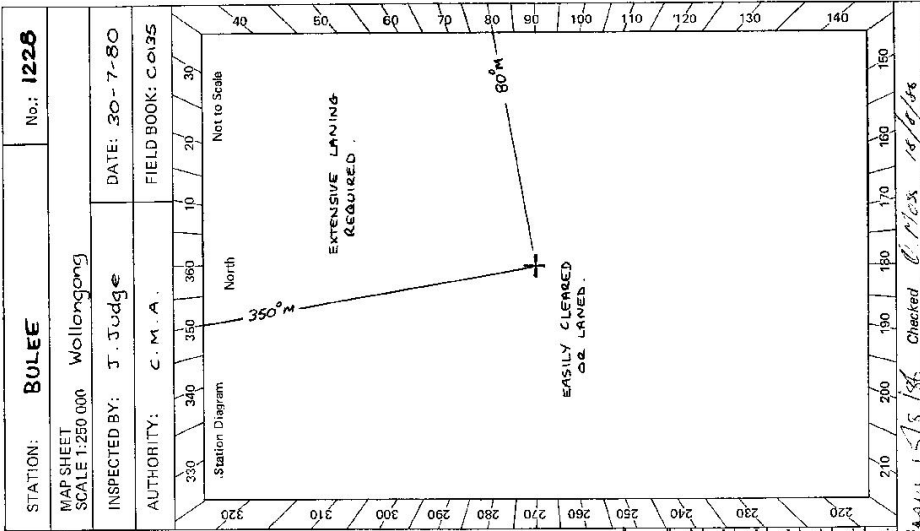

GS 24

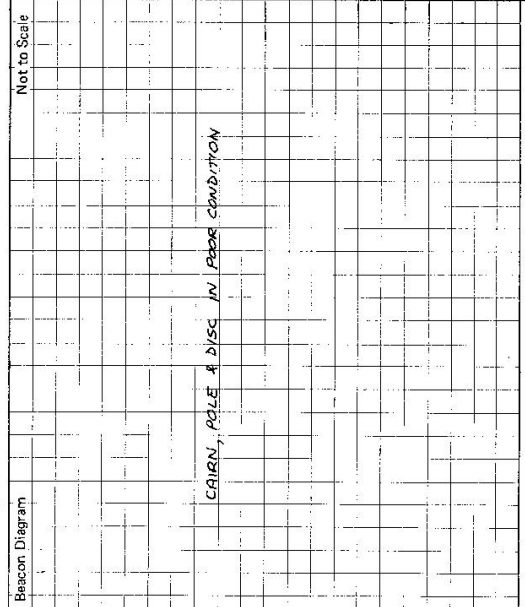STATION	1228																		
<p>Owner's Name: <u>MOSTON NATIONAL PARK</u>                      Address: <u>1st Floor, Housing Commission Bldg</u>  <u>24, BERRY ST., AGERA, 2541</u>                      Phone: <u>(044) 211 9262</u></p> <p>Current Occupant: .....                      Address: .....                      Phone: .....</p> <p style="text-align: center;"><u>ACCESS</u></p> <p>Access Report of <u>30.7.1988</u> was found suitable/unsuitable.</p> <table style="width: 100%; border-collapse: collapse;"> <thead> <tr> <th style="text-align: left; width: 10%;"><u>Km.</u></th> <th style="text-align: left;"><u>Feature</u></th> </tr> </thead> <tbody> <tr> <td>0.0</td> <td>P.O. MERRIGA ~ HEAD TOWARDS NOWRA .</td> </tr> <tr> <td>9.50</td> <td>TURN LEFT JUST OVER CREST OF HILL AND ON RIGHT HAND BEND .</td> </tr> <tr> <td></td> <td>SIGN 'TOUGA'</td> </tr> <tr> <td>18.31</td> <td>SMALL BRIDGE</td> </tr> <tr> <td>18.85</td> <td>PASS TRACK TO COULMBOURGA ON RIGHT</td> </tr> <tr> <td>19.70</td> <td>TAKE RIGHT HAND TRACK ~ PASS TRACK TO 'TOUGA' HOMESTEAD ON LEFT</td> </tr> <tr> <td>23.5</td> <td>PARK TRACK.</td> </tr> <tr> <td></td> <td>ABOUT 5 MINUTE WALK UP HILL ON RIGHT TO TRIG</td> </tr> </tbody> </table>	<u>Km.</u>	<u>Feature</u>	0.0	P.O. MERRIGA ~ HEAD TOWARDS NOWRA .	9.50	TURN LEFT JUST OVER CREST OF HILL AND ON RIGHT HAND BEND .		SIGN 'TOUGA'	18.31	SMALL BRIDGE	18.85	PASS TRACK TO COULMBOURGA ON RIGHT	19.70	TAKE RIGHT HAND TRACK ~ PASS TRACK TO 'TOUGA' HOMESTEAD ON LEFT	23.5	PARK TRACK.		ABOUT 5 MINUTE WALK UP HILL ON RIGHT TO TRIG	<p style="text-align: right;">Not to Scale</p>  <p style="text-align: center;"><u>CAIRN, POLE &amp; DISC IN POOR CONDITION</u></p> <p>This section to be completed by officer constructing pillar.</p> <p>Original station mark found/not found.</p> <p>Description of mark: .....</p> <p>Original beacon found/not found.</p> <p>Description of beacon: .....</p> <p>Height Top of Vanes to Top Mark.....m.</p> <p>Height of mark.....m. above G.L.                      below</p> <p>Diameter of Vanes.....m. Height of Cairn.....m.</p> <p>Original Beacon has/has not been destroyed by me.</p>
<u>Km.</u>	<u>Feature</u>																		
0.0	P.O. MERRIGA ~ HEAD TOWARDS NOWRA .																		
9.50	TURN LEFT JUST OVER CREST OF HILL AND ON RIGHT HAND BEND .																		
	SIGN 'TOUGA'																		
18.31	SMALL BRIDGE																		
18.85	PASS TRACK TO COULMBOURGA ON RIGHT																		
19.70	TAKE RIGHT HAND TRACK ~ PASS TRACK TO 'TOUGA' HOMESTEAD ON LEFT																		
23.5	PARK TRACK.																		
	ABOUT 5 MINUTE WALK UP HILL ON RIGHT TO TRIG																		
Date	Record of Station																		