



LOCALITY SKETCH PLAN

TS12308

SS

MGA E: 540888.83

Replaces TS6660


MGA N: 6822434.11

Datum: ~~MGA94~~ / MGA2020 Zone: ~~54/55~~ / 56 / ~~57/58~~

Coordinates determined by: ~~AUSPOS / RTK / Handheld GNSS / TRAV~~ Other: STATIC GNSS

AHD Level: 137.034 Mark to Ground Level: 1.38 (~~ABOVE GROUND~~ / ~~BELOW GROUND~~)

Height determined by: (Diff Levelling / ~~AUSPOS / RTK / Trig Heighting / Handheld GNSS~~) Other: _____

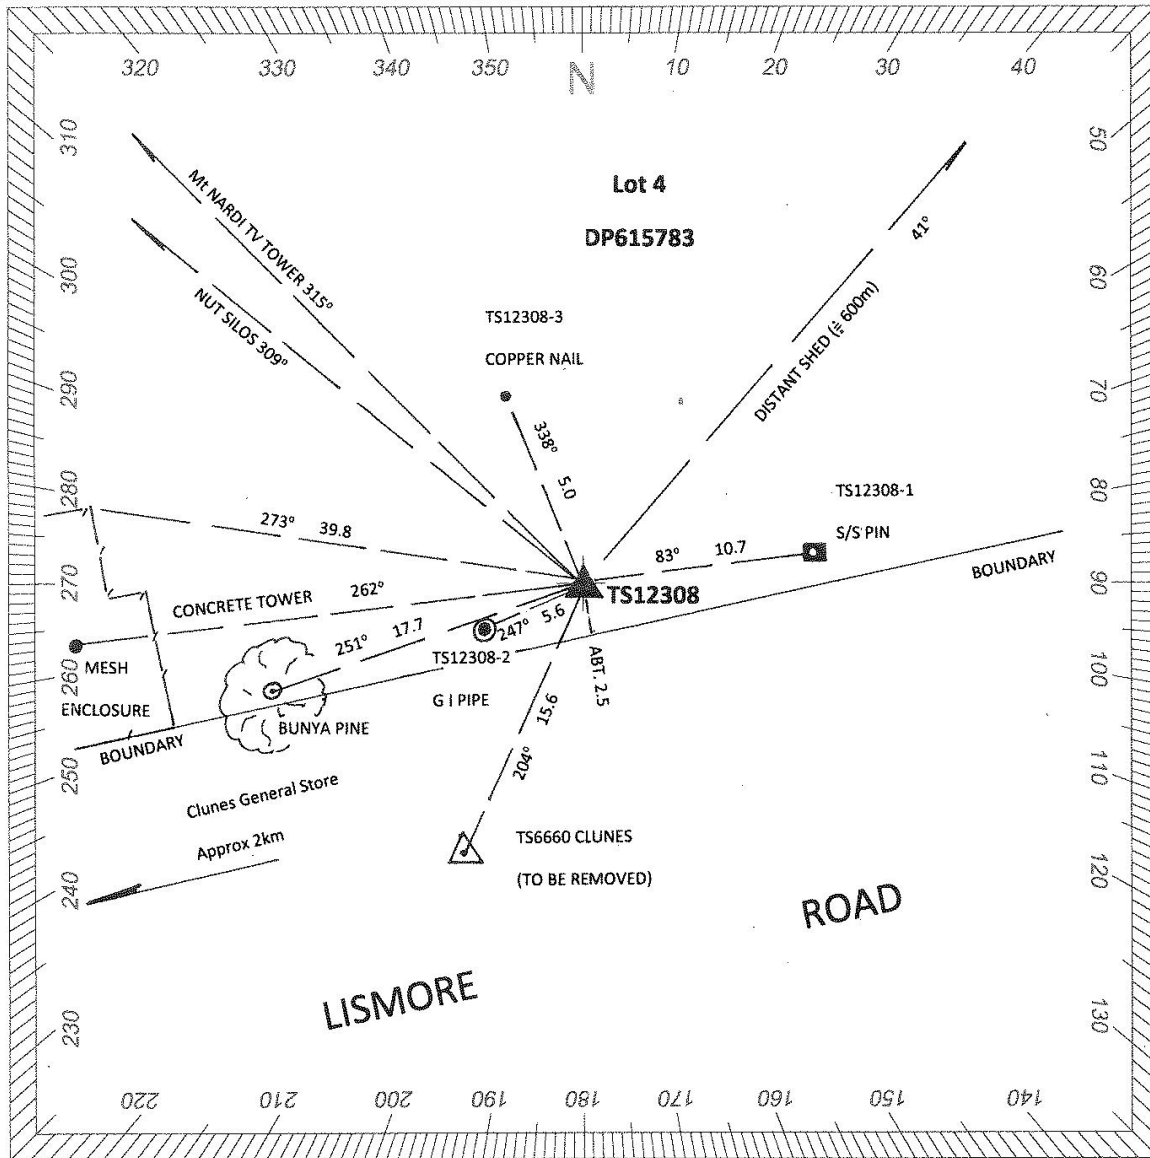

Please use black ink only
Distances shown are in metres
(Refer to Surveyor-General's Direction No. 2 - Preparation of Locality Sketch Plans.)

Town/Suburb/Locality: CLUNES Monument Description: CONCRETE PILLAR

I certify that the mark has been placed/~~found~~ and numbered as detailed hereon. Name of Organisation placing mark: SPATIAL SERVICES

Date mark placed/~~found~~ 2nd JULY 2019 Surveyor's Ref: N/A

Name: DAVE HEGERTY Signed: _____



LOCALITY SKETCH PLAN

TS12308

SS

MGA E: 540888.83

Replaces TS6660


MGA N: 6822434.11

Datum: ~~MGA94~~ / MGA2020 Zone: ~~54/55~~ / 56 / ~~57/58~~

Coordinates determined by: ~~AUSPOS / RTK / Handheld GNSS / TRAV~~ Other: STATIC GNSS

AHD Level: 137.034 Mark to Ground Level: 1.38 (ABOVE GROUND / ~~BELOW GROUND~~)

Height determined by: (Diff Levelling / ~~AUSPOS / RTK / Trig Heighting / Handheld GNSS~~) Other: _____

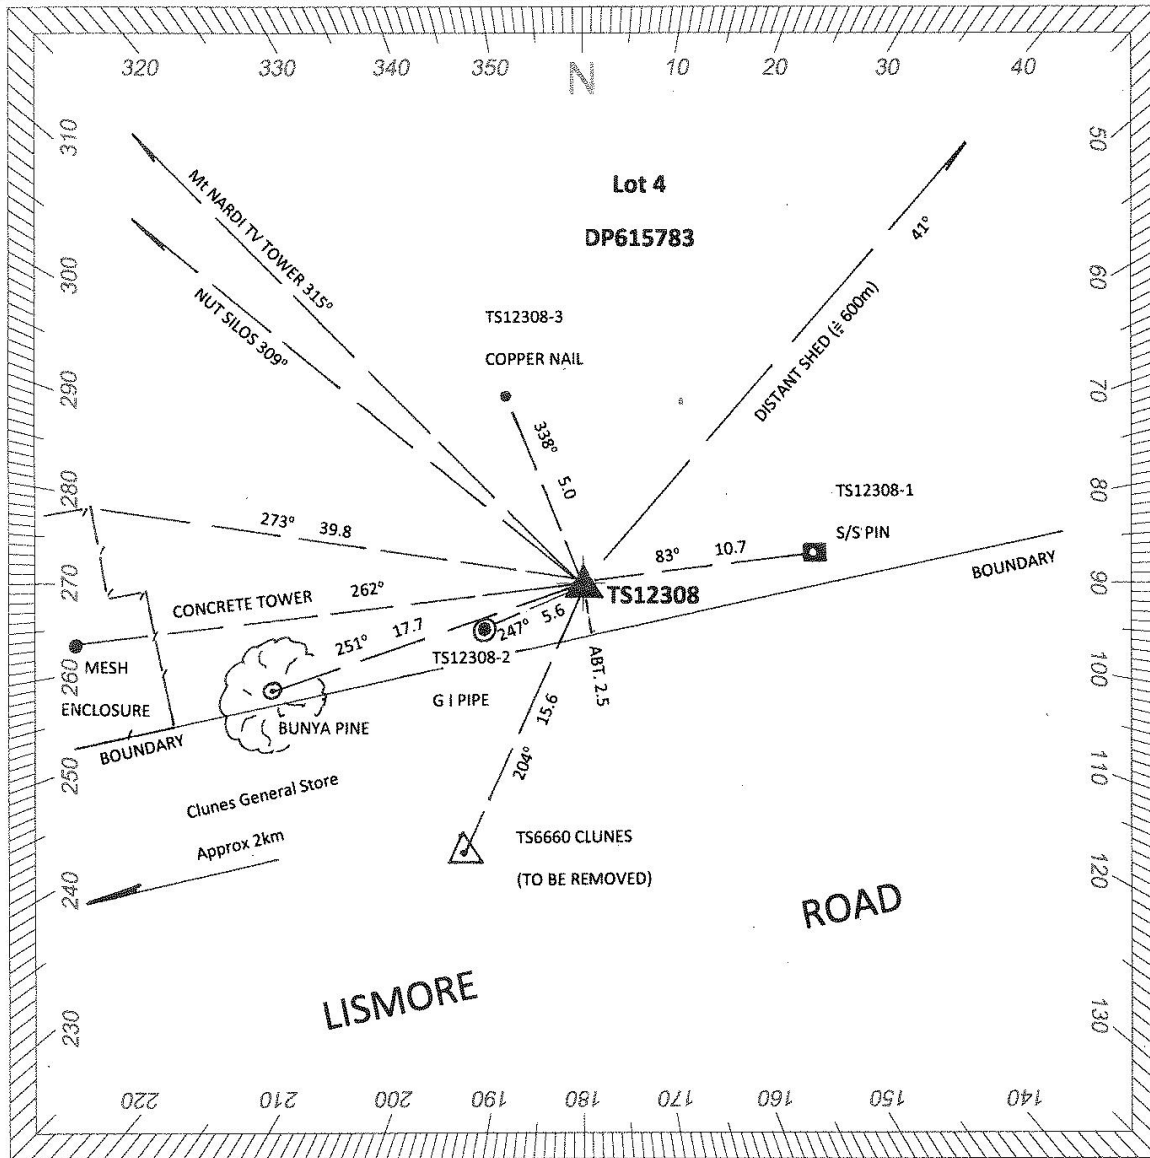

Please use black ink only
Distances shown are in metres
(Refer to Surveyor-General's Direction No. 2 - Preparation of Locality Sketch Plans.)

Town/Suburb/Locality: CLUNES Monument Description: CONCRETE PILLAR

I certify that the mark has been placed/~~found~~ and numbered as detailed hereon. Name of Organisation placing mark: SPATIAL SERVICES

Date mark placed/~~found~~ 2nd JULY 2019 Surveyor's Ref: N/A

Name: DAVE HEGERTY Signed: _____