

GEODETTIC SURVEY OF N.S.W.

CENTRAL MAPPING AUTHORITY

GEODETTIC STATION RECONNAISSANCE and MAINTENANCE REPORT

STATION: **BULGO G.S.** No.: **1234**

MAP SHEET SCALE 1:250 000 **NOLLONGONG**

INSPECTED BY: **M.L. Morrison** DATE: **24/1/80**

AUTHORITY: **C.M.A.** FIELD BOOK: **CA025**

Description: *Note: Cross out word or words which do not apply*
 1. Cleared by lanes bearing **N.11. CARRIAGE DOCK COMPLETELY from Trig. Mast**
TIMBERED

2. Mast & Vanes have been painted white & black respectively.

3. The station/pillar was unpainted/~~constructed~~ on **2.11.1980**, dimensions now being:

Description of mark **Steel Plate**, should be explicit, e.g. S/Steel Pillar Plate, Steel plug, Brass plug, Bolt, G.I. Pipe

Height of mark **0.110** m. ^{above} ~~mark~~ **concrete**; Mark is **about** m. ^{above} ~~below~~ G.L.

Height of Top Vanes to Top Mark/Pillar/Pole **3.038** m. Diameter of Vanes (vertical) **0.605** m.

Height of Cairn **0.16** m. Diameter of Cairn **0.16** m. Name Plate/~~found~~/~~not found~~/~~placed~~

Length of Mast **3.048** m. (approximate if not unpainted)

4. A. ~~set in conc/rock has been placed~~ found, bearing.....° M from Mast/Plug/Pillar

5. A. ~~set in conc/rock has been placed~~ found, bearing.....° M from Mast/Plug/Pillar

6. A. ~~set in conc/rock has been placed~~ found, bearing.....° M from Mast/Plug/Pillar

7. A. ~~set in conc/rock has been placed~~ found, bearing.....° M from Mast/Plug/Pillar

8. Action required:.....

STANDPOINT:


STANDPOINT:

Mark	Direction	Horiz. Distance	Height Difference	Mark	Direction	Horiz. Distance	Height Difference
			above standpt.				above standpt.
			below standpt.				below standpt.
			above standpt.				above standpt.
			below standpt.				below standpt.
Prepared by: *[Signature]* 24/1/80 Checked: *[Signature]*

Noted on U.T.M. Card

Checked

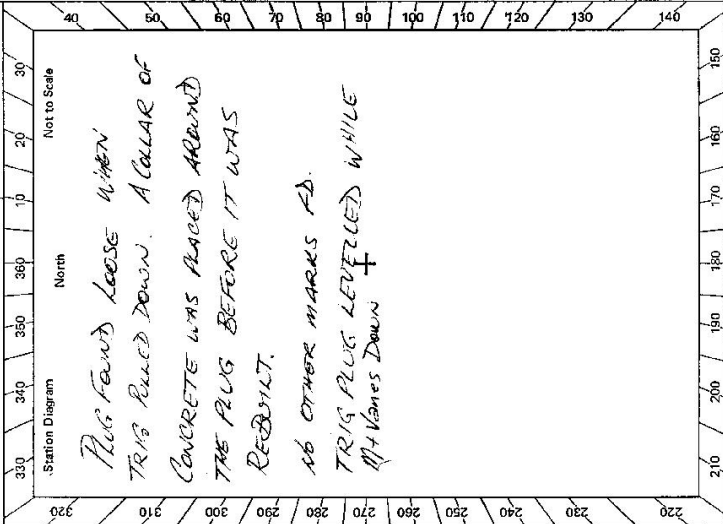

STATION <u>B.L. 60</u> 1234	Owner's Name: <u>ROYAL NATIONAL PARK</u> Address: <u>AULDLEY</u> Phone: <u>N.S.O.</u> Current Occupant: <u>R.N.P.</u> Address: Phone: Access Report of: <u>ACCESS</u> was found suitable/unsuitable.
Beacon Diagram Not to Scale	
This section to be completed by officer constructing pillar.	
Original station mark found/not found.	
Description of mark:	
Original beacon found/not found.	
Description of beacon:	
Height Top of Vanes to Top Mark:m.	
Height of mark:m. above G.L. below	
Diameter of Vanes:m. Height of Cairn:m.	
Original Beacon has/has not been destroyed by me.	
Date	Record of Station