

CENTRAL MAPPING AUTHORITY

GEODETIC SURVEY OF N.S.W.

GEODETIC STATION RECONNAISSANCE and MAINTENANCE REPORT

Description:

- Note: Cross out word or words which do not apply*
- Cleared by lanes bearing $177^{\circ} - 190^{\circ}$ M. 150.157 M. 150.174 M. from Trig. Mast
Mast & Vanees have been painted white & black respectively. $257^{\circ} - 265^{\circ}$ M. $279^{\circ} - 292^{\circ}$ M.
 - The station/pillar was ~~replaced~~/not unpiled/~~constructed~~ on 1 December 1932, dimensions now being:
Description of mark..... should be explicit, e.g. S/Steel Pillar Plate, Steel plug, Bolt, G.I. Pipe
Height of mark..... m. above rock/concrete; Mark is..... m. above G.L.
Height of Top Vanes to Top Mark/Pillar plate..... m. Diameter of Vanes (vertical)..... m.
Height of Cairn..... m. Diameter of Cairn..... m. Name Plate...../not found/~~placed~~.
Length of Mast..... m. (approximate if not unpiled)
 - A..... S.S.M..... set in conc/~~rock~~/has been ~~placed~~/found, bearing..... 165° M from Mast/~~Plug/Pillar~~
A..... set in conc/rock has been placed/found, bearing..... $^{\circ}$ M from Mast/~~Plug/Pillar~~
A..... set in conc/rock has been placed/found, bearing..... $^{\circ}$ M from Mast/~~Plug/Pillar~~
A..... set in conc/rock has been placed/found, bearing..... $^{\circ}$ M from Mast/~~Plug/Pillar~~
 - Action required: Quartzite G.L. bearing is required, plus place concrete pillar.

STANDPOINT:

Mark	Direction	Horiz. Distance	Height Difference	Mark	Direction	Horiz. Distance	Height Difference
Stations visible from Bullseye	Bullseye	G.S.	above standpt.				above standpt.
Abundance G.S. (hill only)	25°		below standpt.				below standpt.
ONKEY (P) G.S.	69°		below standpt.				below standpt.
Mumbarta G.S. (hill only) lat. P.			above standpt.				above standpt.
Mooran G.S. Bullseye G.S. (hill only) lat. P.			above standpt.				above standpt.
Bungadah G.S.?	299°		below standpt.				below standpt.

Prepared by: D. KAIN

Checked: Noted on U.T.M. Card

SK 2733-1

STATION: Bullseye G.S. No: 1239
 MAP SHEET SCALE 1:250 000
 INSPECTED BY: D.J. KAIN DATE: 7 December 1932
 AUTHORITY: C.M.A. FIELD BOOK: 1932.

Station Diagram
 North
 Not to Scale

PERMISSION from Mr. I. Daly Dubbs L.B.O. And Lesca Mr. Mitchell for total clearing given
 Note:- Some Kuyupung trees black vision.
 Estimate time for clearing two men with Chain Saw one DAY.


Bullseye G.S.
 (TAG MAST)

2260M
 345M

5.5M in Concrete (found)

Checked

4: 2733-2 D. West, Government Printer

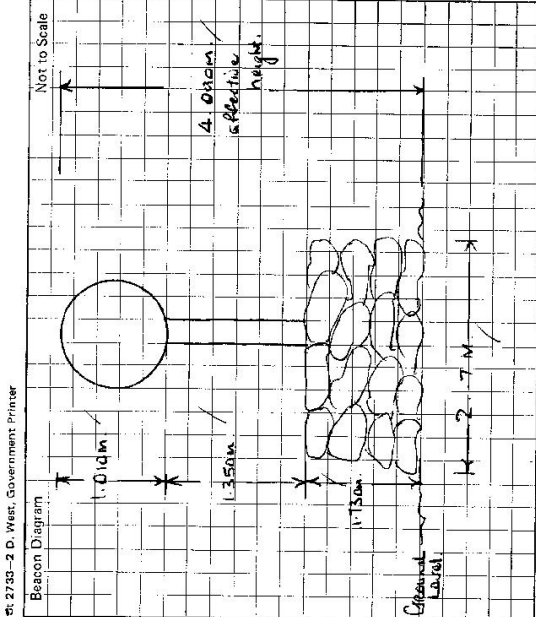

This section to be completed by officer constructing pillar.

Original station mark ~~found~~/not found.

Description of mark:

Original beacon found/not found.

Description of beacon:

Height Top of Vanes to Top Markm.

Height of markm. above G.L.
below

Diameter of Vanesm. Height of Cairnm.

Original Beacon has/has not been destroyed by me.

STATION Bullaroy G.S. 1239

Owner's Name: Eric Reserve No. 47929.

Address: PERMISSION OCCUPANCY HELD BY

DR. JOHN FREDERICK MITCHELL 32 BEDFORD ROAD

BLACKTOWN, N.S.W. (02) 622 1845

Current Occupant:

Address:

Phone:

ACCESS

Access Report of 27/4/1917 was found ~~unsuitable~~.

Deniable access to Bullaroy G.S.

FEATURE

At MEERALIBA VILLAGE on Coolah - Binnaway Road on Corner

of Binnia Street, TRAVEL TOWARD Binnaway.

Turn left down gravel ROAD.

PASS McGuinness ROAD on your L.H.S. (Owner's father

MR. FRED MITCHELL lives at this property.)

10.28 / OVER CONCRETE CAUSEWAY.

11.09 / OVER STEEL GRID SHEEDING'S SHEET ON YOUR R.H.S. (Track is

12.42 / TAKE TRACK OFF TO YOUR LEFT THROUGH CLEARING - (Track is

13.28 / NEARLY OPPOSITE GATE TO HOMESTEAD) FOLLOW TRACK THROUGH

CLEARING AND THEN THROUGH TIMBER.

14.39 / TAKE RIGHT TRACK OVER CREEK

15.06 / PASS DAM ON YOUR L.H.S., follow faint but definite track through

15.62 / AT CLEARING TRACK GOES ACROSS Small Gully Then

heads generally in a westerly direction working

its way around base of hill and up slope.

17.72 / Bullaroy G.S.

Track from 15.62 kms is faint at times but with

Careful observation can be followed right to station.

Note:

Date


Record of Station

STATION **TS 1239** (BULLAROO)

Owners Name..... Current Occupant.....

Address.....

Access 15-10-82
 From Waatarlibah take Gamble Creek Rd for 12.3 km to faint track on left opposite house, follow track across clearing and thru timber. Cross creek and follow track for 100m then sharp left, follow east dam and thru clearing to blazed trail to Trig.

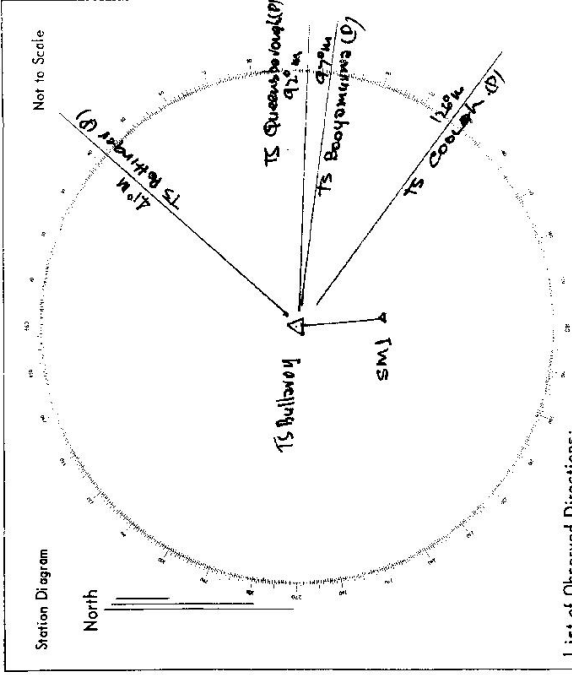

List of Observed Directions:-

Standpoint: SMA		Standpoint:	
Station	Direction	Station	Direction
TS Quasabungah (P)	97° 30' 00"		
TS Booyemungah (P)	97° 23' 19.2"		
TS Coomah (P)	126° 31' 04.8"		
TS Bullaroo	345° 58' 08.5"		
TS Pettungah (P)	41° 25' 17.9"		
Station	Direction	Station	Direction